COMSTOCK AND DAVIS INC.

3092 N. LEXINGTON AVE. ST. PAUL, MN. 55113 483-4408

SURVEYED FOR: Rosewood Estates

See attached survey for Peggy Slater dated ;9/16/93

DESCRIPTION; Lot 1, Block 2 , Ralph G. Miller Addition and part of the South 200 feet of Government Lot 3, Section 2, Township ;29, Range 23 lying Easterly of Victoria Avenue as opened widened per Document #2242697

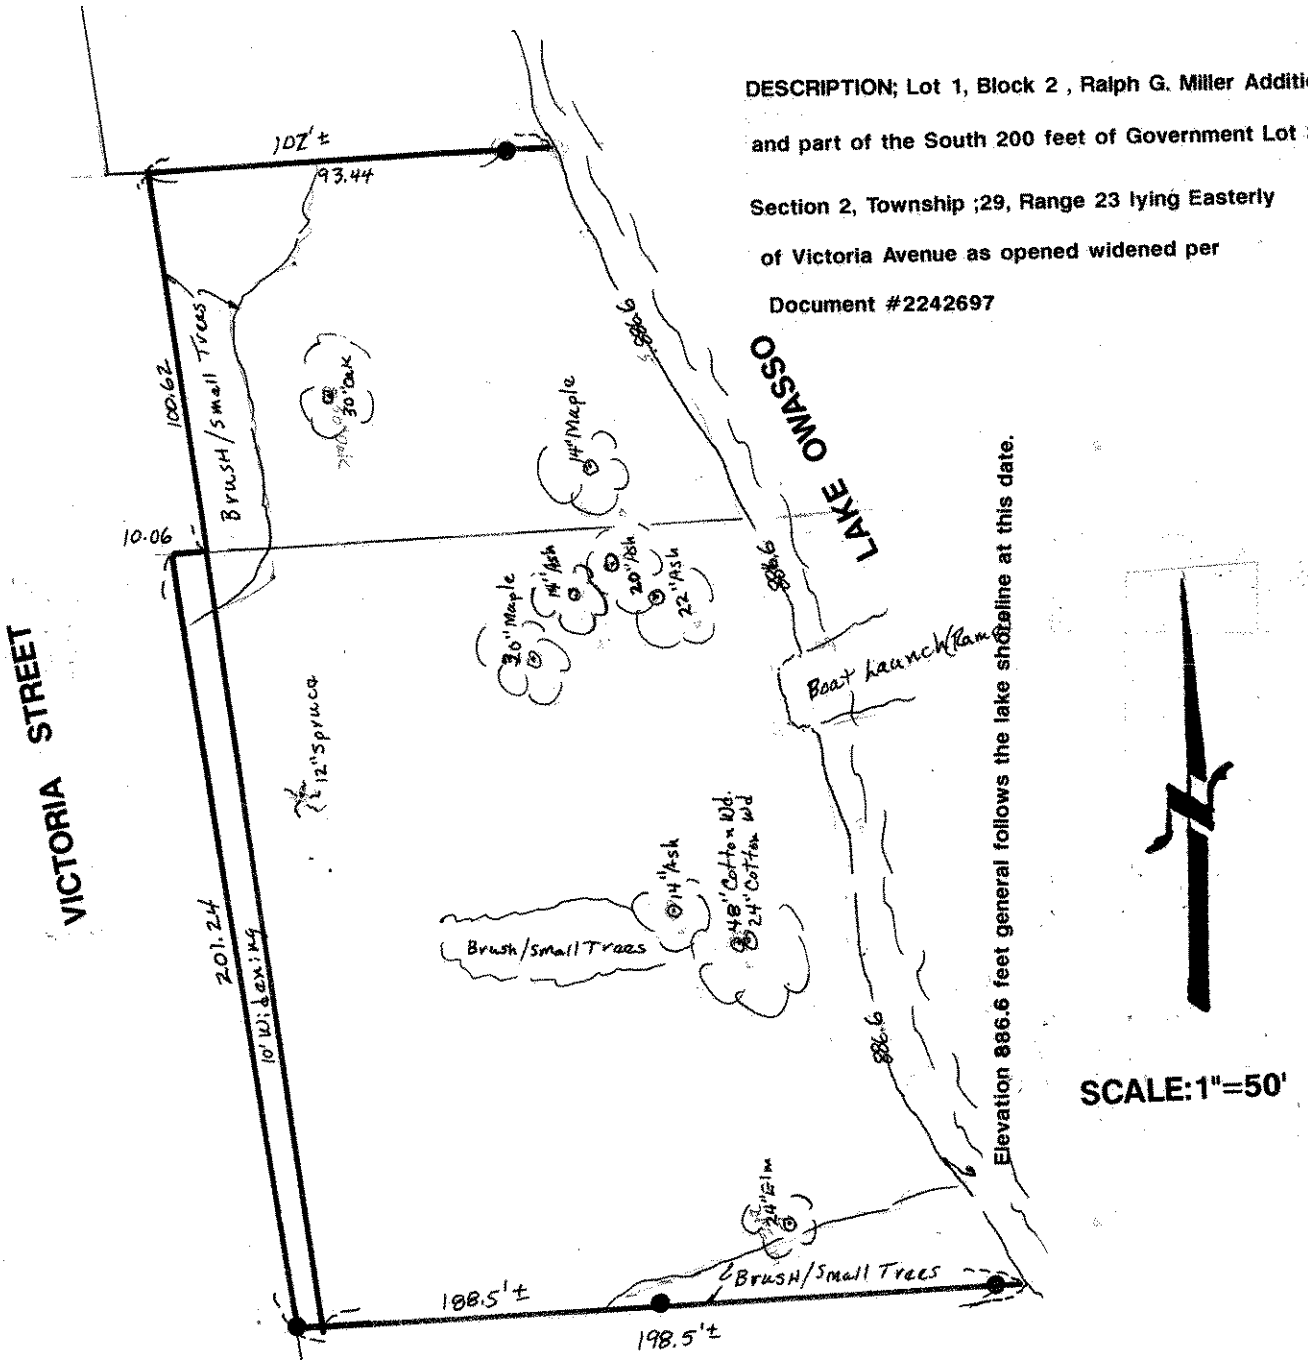

SCALE:1"=50'

I hereby certify that this survey, plan plat, preliminary plat or report was prepared by me or under my direct supervision and that I am a duly Registered Land Surveyor under the laws of the State of Minnesota.

Donald Schmidt

10459	6/25/93	931323	
Reg. No.	Date	Job No.	Book No.