
COMSTOCK AND DAVIS INC.

3092 N. LEXINGTON AVE. ST. PAUL, MN. 55113 483-4408

SURVEYED FOR: Linda Schumacher

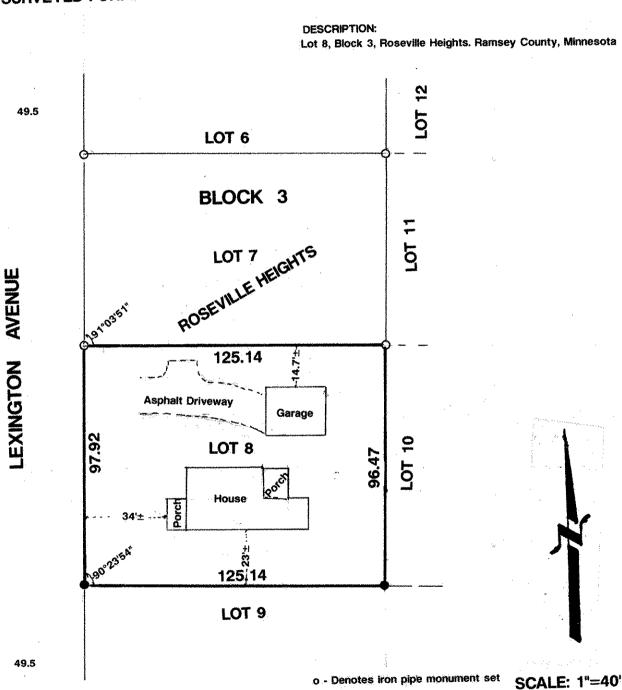

Surveyed according to Section monuments inplace and irons found in block.

I hereby certify that this survey, plan plat, preliminary plat or report was prepared by me or under my direct supervision and that I am a duly Registered Land Surveyor under the laws of the State

Denotes iron found inplace

of Minnesota.

Au Odu Schwiedl

Reg. No.

Date

10459

A 10459

Date

Job No.

Book No.

West line of SW 1/4 of Section 2,729N,R23W