29-22

COMSTOCK AND DAVIS INC.

3092 N. LEXINGTON AVE. ST. PAUL, MN. 55113 483-4408

AMERICAN HOME & CONSTRUCTION INC. (David Wright)

DESCRIPTION:
That part of Lots 32 and 33, Block 3, Gervais Heights which lies South the North 21 feet of said Lot 33 and which lies West of the East 77.0 feet thereof, and which lies East of the following described parcel:

The West half of that part of Lots 32 and 33, Block 3, Gervais Heights which lies West of the East 30 feet of said Lots.

Ramsey County, Minnesota

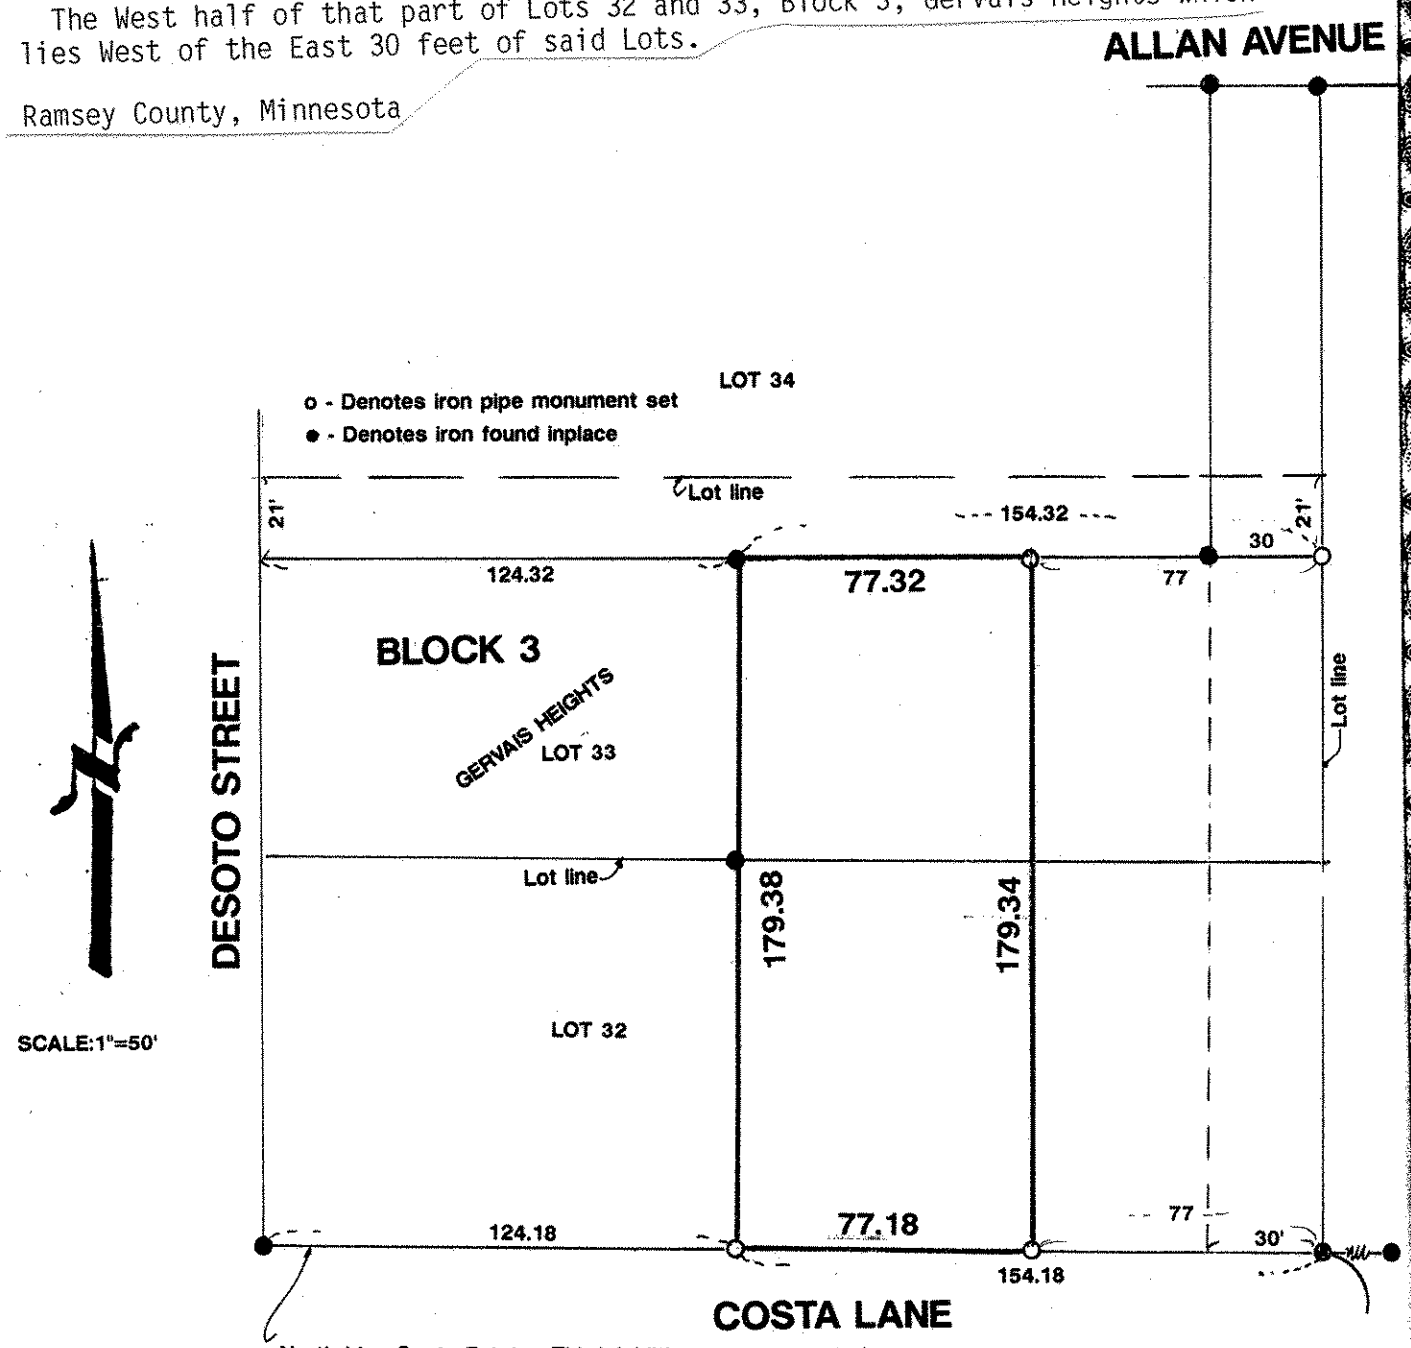

I hereby certify that this survey, plan plat, preliminary plat or report was prepared by me or under my direct supervision and that I am a duly Registered Land Surveyor under the laws of the State of Minnesota.

Donald W. Schmidt	10459	4/22/93	931282	
	Reg. No.	Date	Job No.	Book No.