


Approved
City of Shoreview
7/20/00

* Provide Approved
Plans on Site
* Subject to Field
INSP.

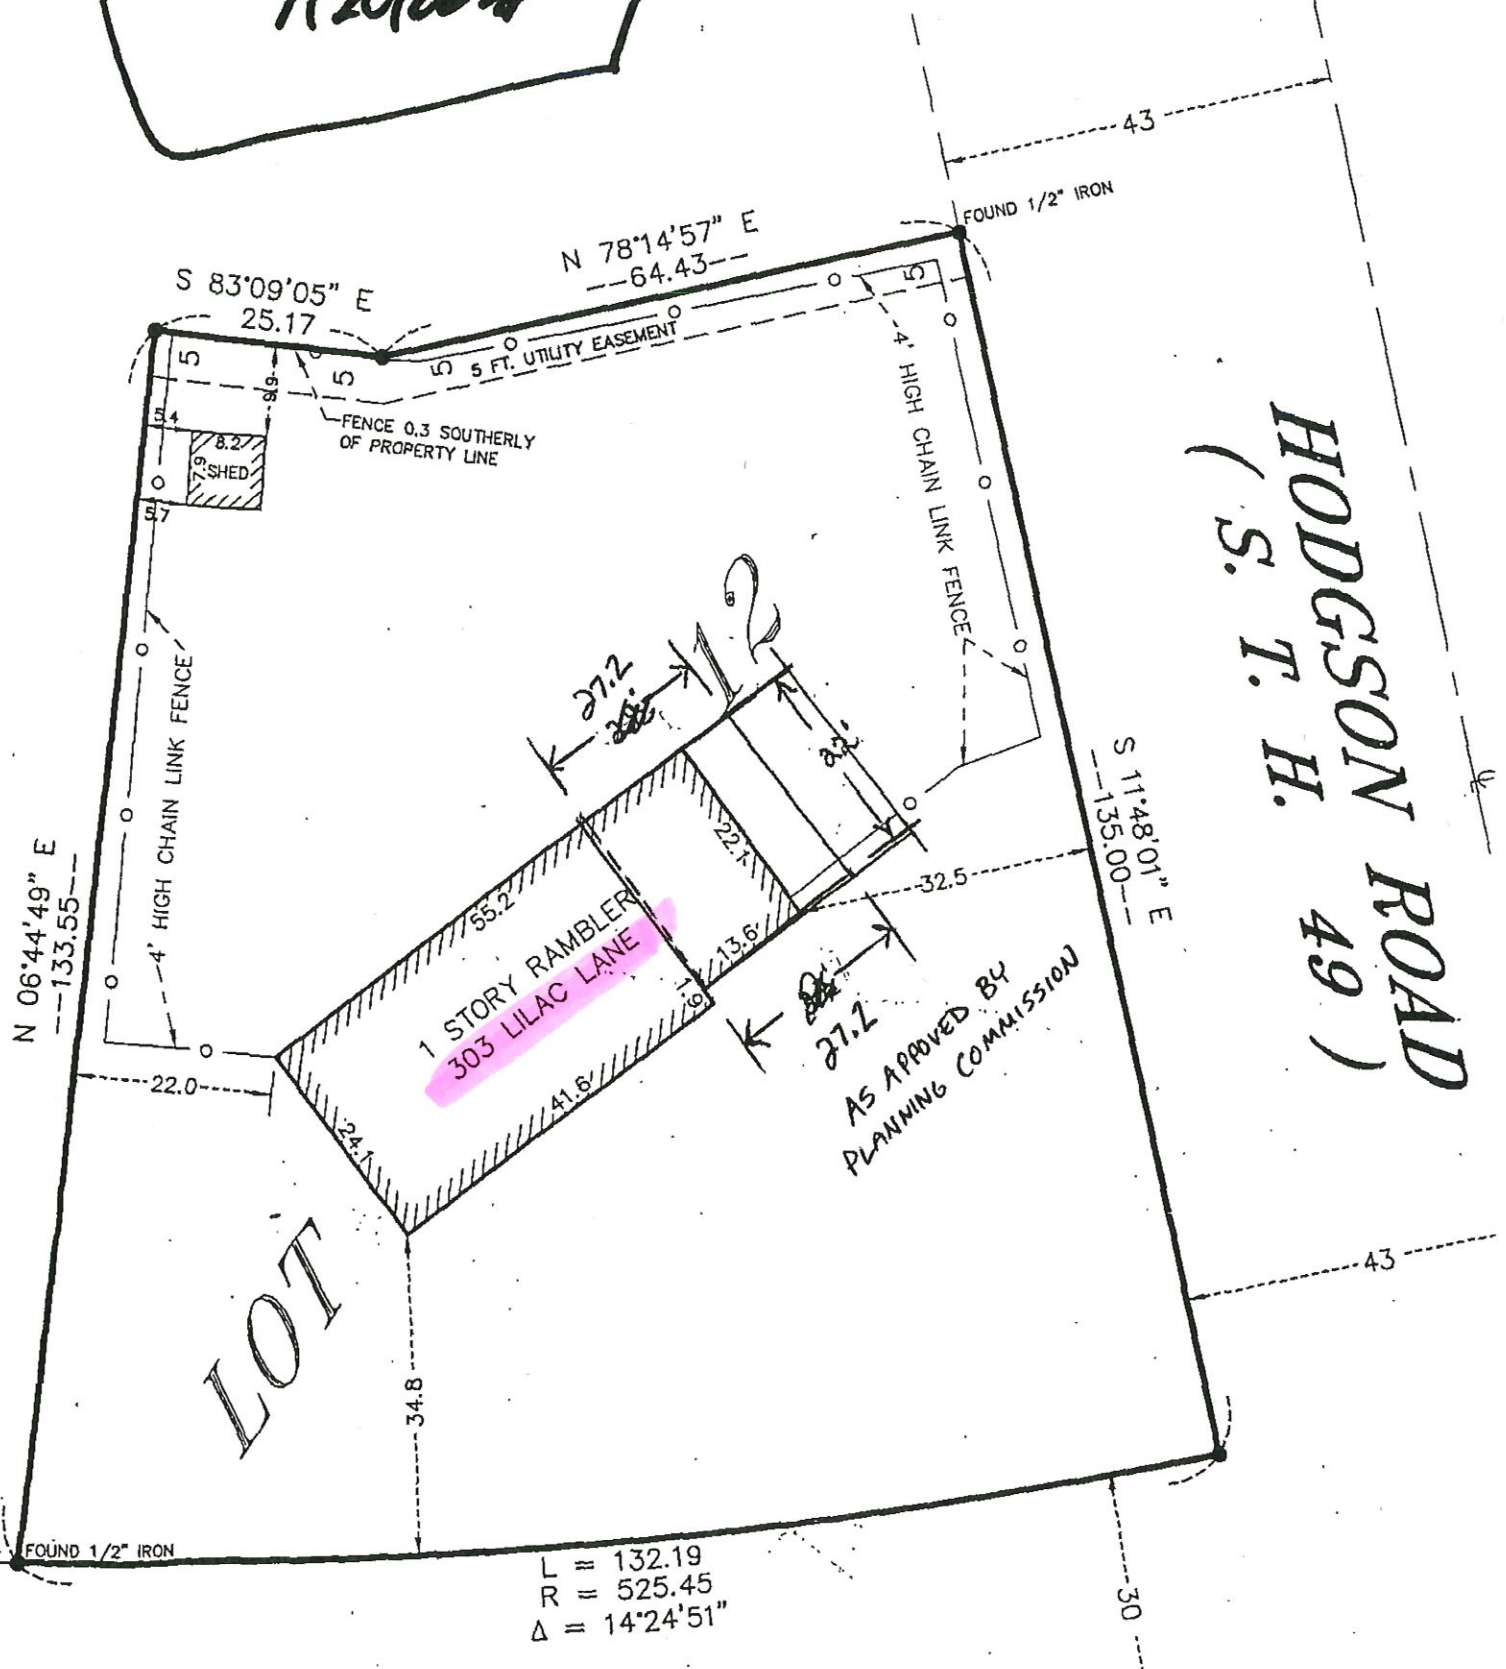

HODGSON ROAD
(S. T. H. 49)

L = 132.19
R = 525.45
Δ = 14°24'51"