NE 10 29 23

FROM THE OFFICE OF

CHARLES O. GEORGI COMPANY

2215 West County Road B — Saint Paul, Minnesota 55113

REGISTERED CIVIL ENGINEER AND LAND SURVEYOR

Certificate of Survey

I Hereby Certify that this plat shows a survey made by me of the property described on this plat, and that the corners are correctly placed as shown, and that all locations have been correctly shown.

Surveyed For Herman Simonsen

Date

Scale 1" = 50'

By

REGISTERED LAND SURVEYOR

Description:
The North 108.9 feet of the South 258.9 feet of the West 290.4 feet of the North ¼ of the North East ¼ of Sec. 10 T29 R23, except East 85 feet thereof, subject to Hamline Ave, Ramsey County, Minnesota.

WORK SHEET

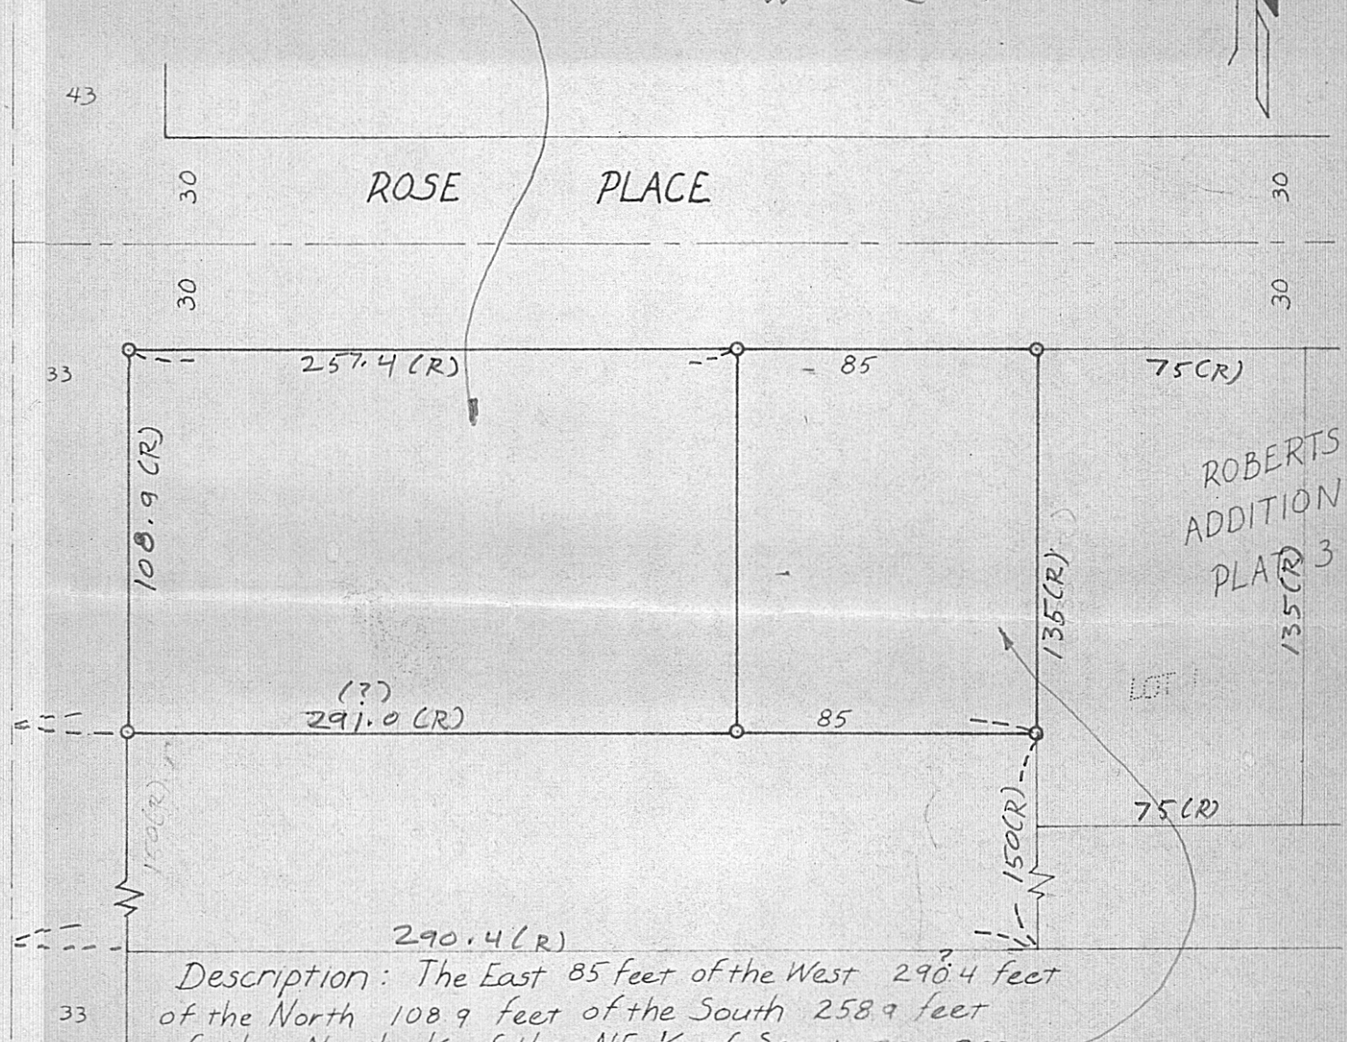

Description: The East 85 feet of the West 290.4 feet of the North 108.9 feet of the South 258.9 feet of the North ¼ of the NE ¼ of Sec. 10 T29 R23, Ramsey County, Minnesota.

o Iron Pipe Monument