W. F. BRETTSCHNEIDER

Registered Civil Engineer and Land Surveyor

Phone: Midway 5-7505 — 1160 Charles Ave. - St. Paul 4, Minn.

Scale: 1 inch 100 feet.

PLAT OF SURVEY

o Indicates Iron

OF PROPERTY OF Ed Brandl

described as follows: Plat Showing Proposed Layout Of Lots Along Otter Lake Road In The Northeasterly Part Of Gov. Lot 1 Sec 3 T30 R 22

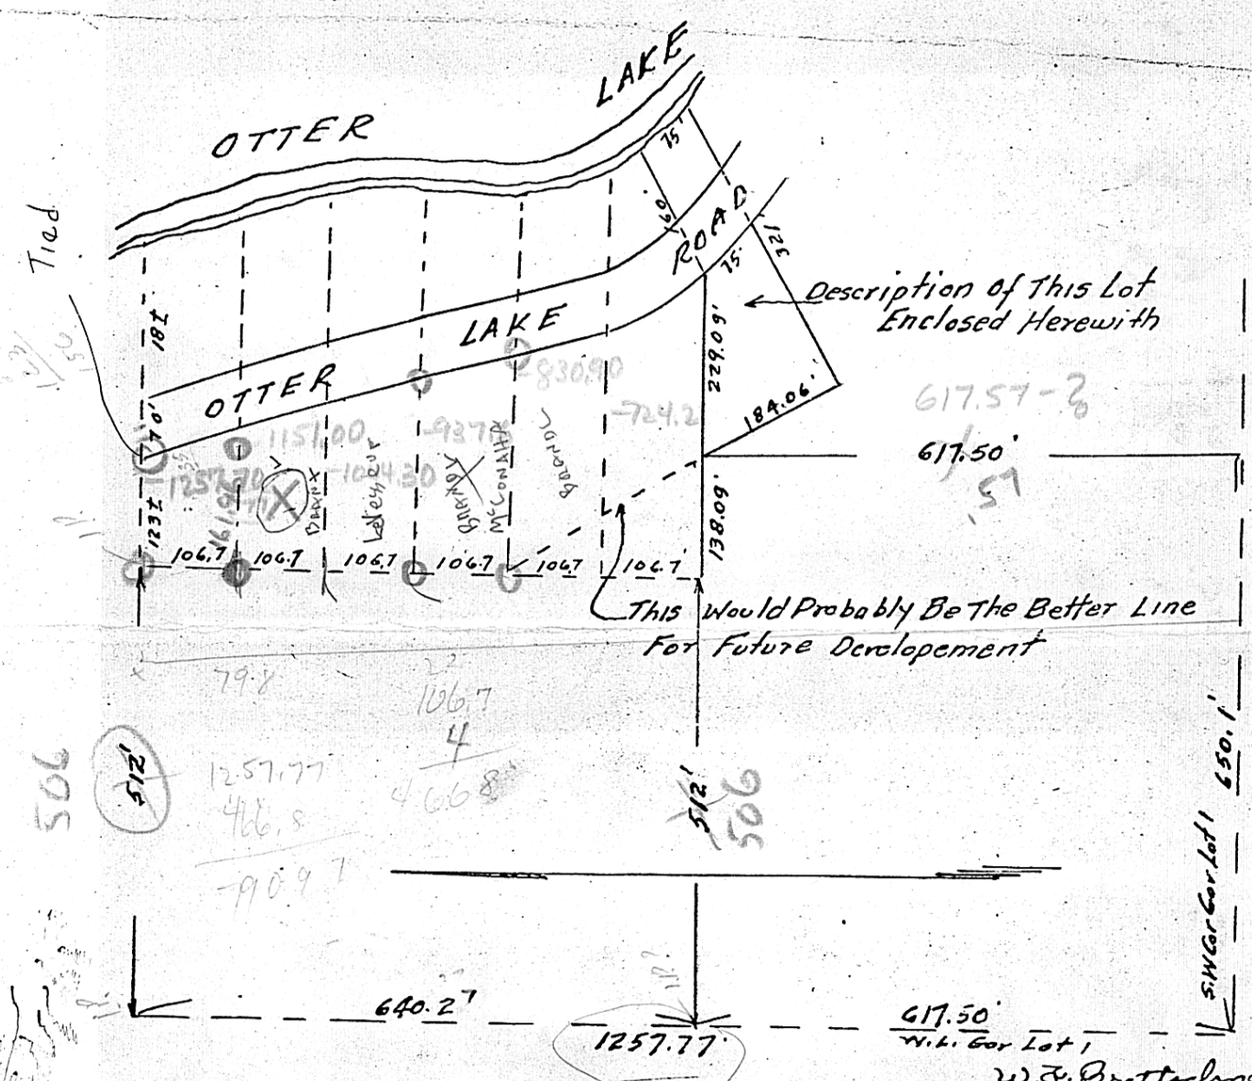

W. F. Brettschneider

CERTIFICATE OF LOCATION OF BUILDING

I hereby certify that on_____, 19____ I made a survey of the proposed location of the building on the above described property and that the location of said building is correctly shown on the above plat.

CERTIFICATE OF SURVEY

I hereby certify that on_____, 19____ I surveyed the property described above and that the above plat is a correct representation of said survey, and there are no encroachments except as shown hereon.