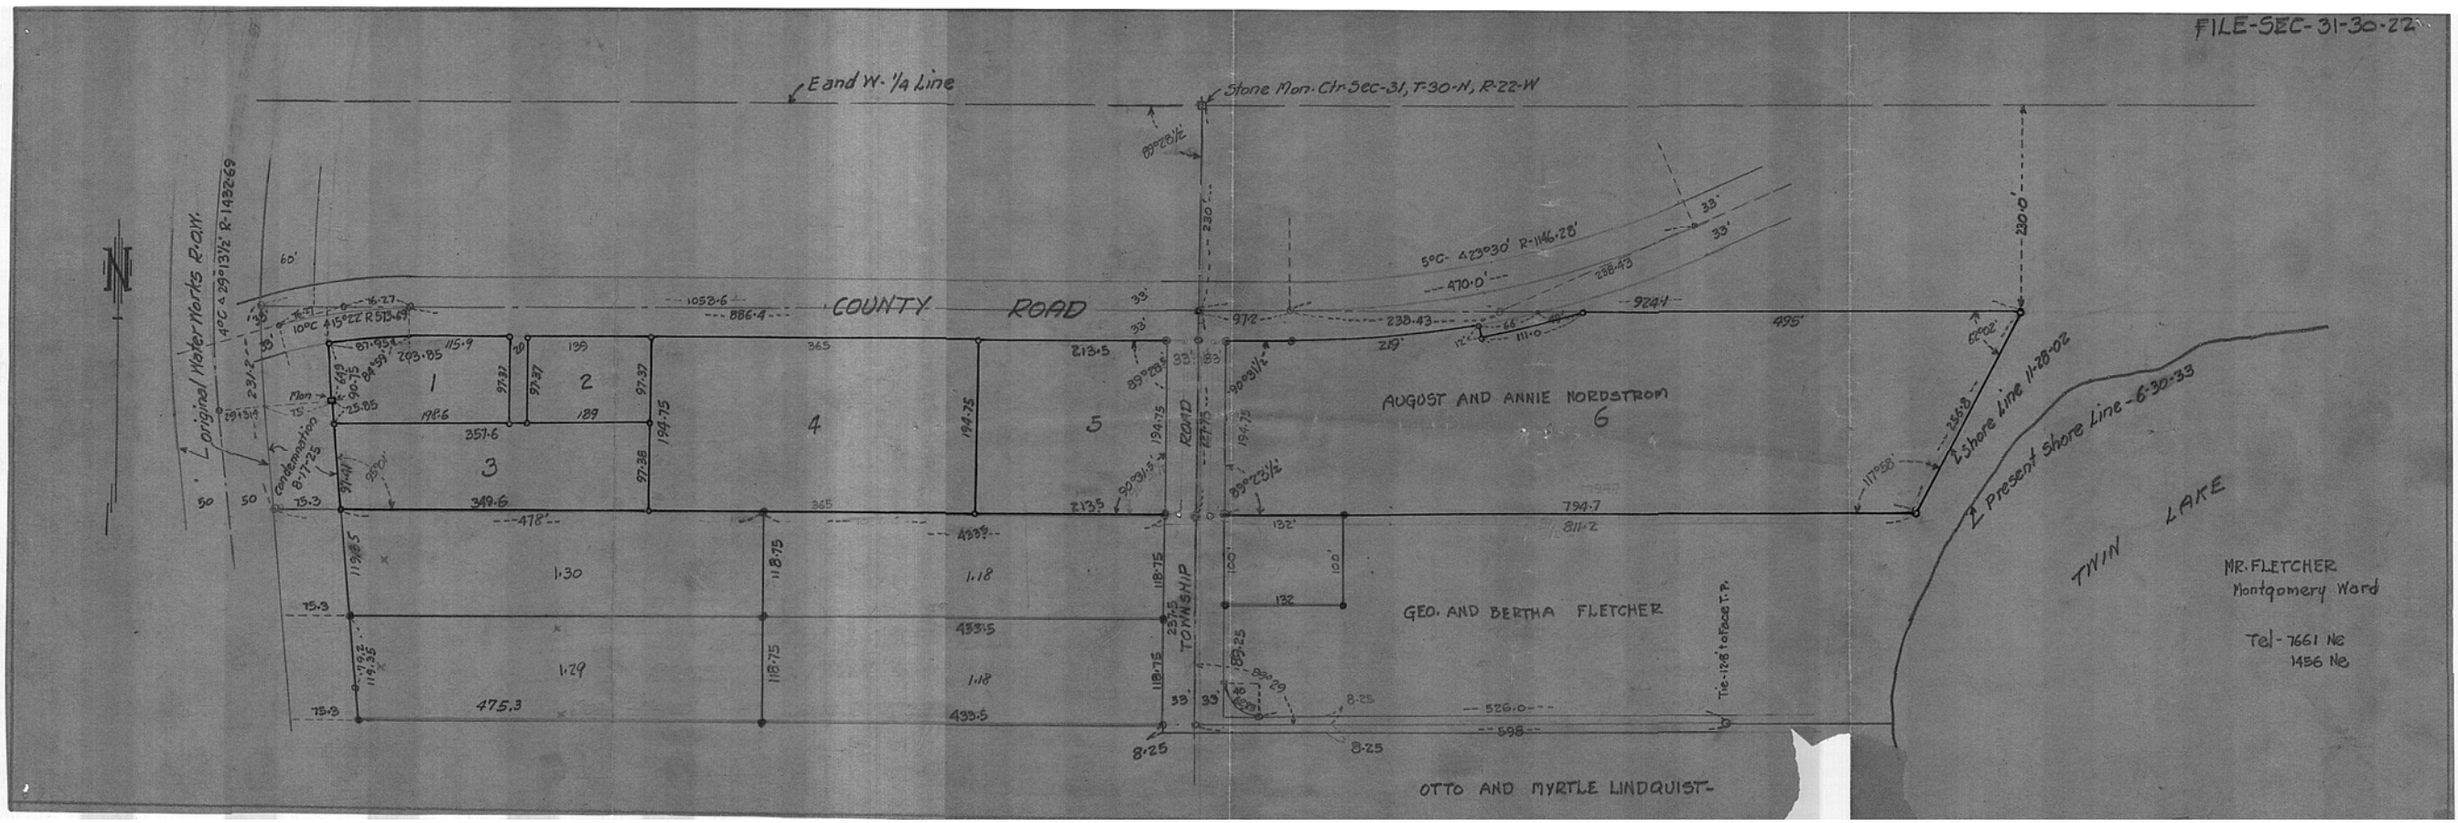
FILE-SEC-31-30-22
E and W. 1/4 Line
Stone Mon. Ctr. Sec-31, T-30-N, R-22-W
COUNTY ROAD
AUGUST AND ANNIE NORDSTROM
GEO. AND BERTHA FLETCHER
OTTO AND MYRTLE LINDQUIST
TOWNSHIP ROAD
TWIN LAKE
Shore Line 11-28-02
Present Shore Line - 6-30-33
Original Water Works R.O.W.
Condemnation 8-17-25
MR. FLETCHER
Montgomery Ward
Tel - 7661 Ne
1456 Ne