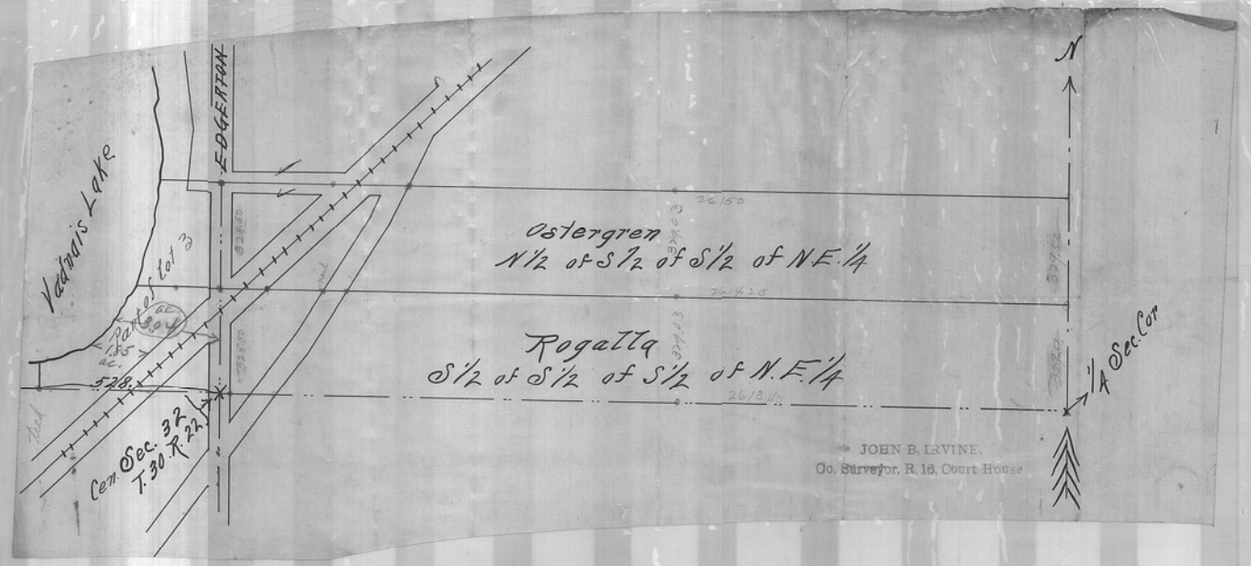
Vadnais Lake
EDGERTON
Ostergren
N½ of S½ of S½ of NE¼
Rogalla
S½ of S½ of S½ of NE¼
N
¼ Sec Cor
Cen Sec. 32
T. 30 R. 22
JOHN B. IRVINE.
Co. Surveyor, R. 16, Court House