


- PARCEL # 7 ACQUIRED
- PARCEL # 8 DAYTON DEVELOPMENT COMPANY
- PARCEL # 9 ROBERTS CONSTRUCTION CO. THE EQUITABLE LIFE ASSURANCE SOCIETY OF THE UNITED STATES KAISER JEEP SALES
- PARCEL #10 MCGOUGH CONSTRUCTION COMPANY, INC. TWIN CITY FEDERAL SAVINGS AND LOAN ASSOCIATION STANDARD OIL COMPANY WILLIAMS BROTHERS PIPELINE COMPANY
- PARCEL #11 NORTHERN STATES POWER CO. WILLIAMS BROTHERS PIPELINE COMPANY STANDARD OIL COMPANY
- PARCEL # 12 VILLAGE OF ROSEVILLE WILLIAMS BROTHERS PIPE LINE COMPANY NORTHERN STATES POWER COMPANY STANDARD OIL COMPANY
- PARCEL #13 WILLIAMS BROTHERS PIPELINE COMPANY NORTHERN STATES POWER COMPANY STANDARD OIL COMPANY

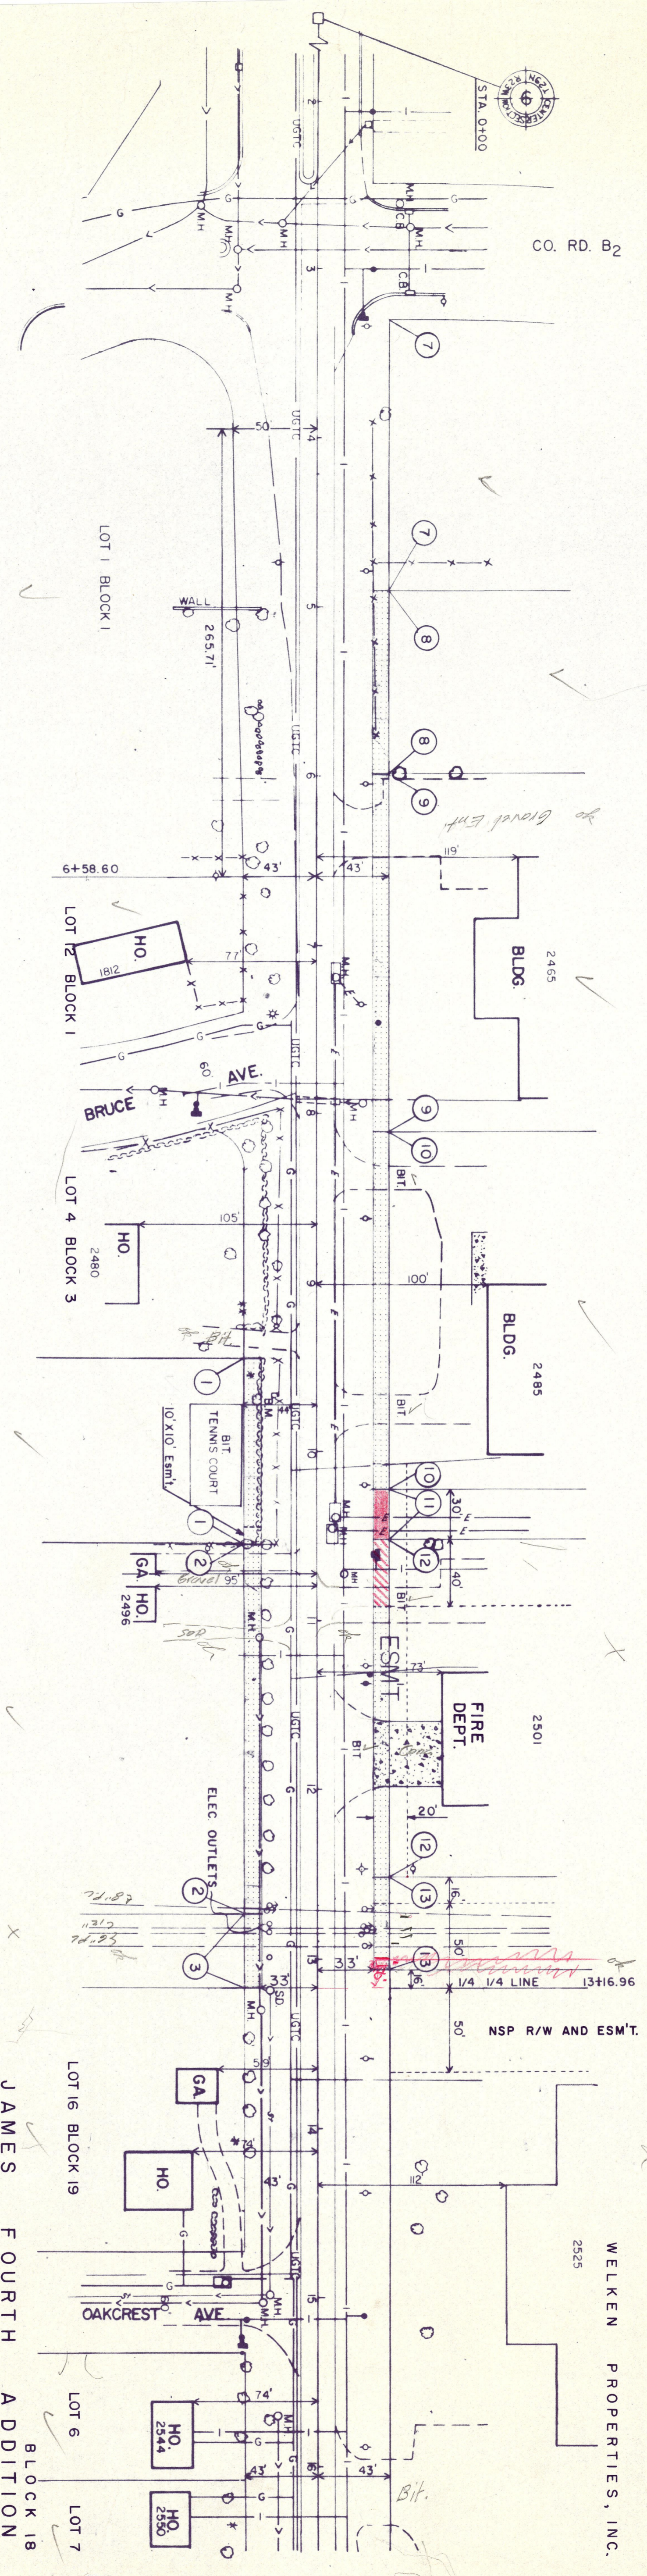

ROSEDALE CENTER FIRST ADDITION

FAIRVIEW HILLS

PARCEL # 1 DAVID ALAN MORGAN HEDI MORG MORGAN NORTHERN STATES POWER COMPANY

PARCEL # 2 CLIFFORD J. PAFF COMPANY PIPE LINE COMPANY NORTHERN STATES POWER COMPANY


PARCEL # 3 WILLIAMS BROTHERS PIPE LINE COMPANY

JAMES FOURTH ADDITION

**OFFICE OF
RAMSEY COUNTY ENGINEER**

DEANE R. ANKLAN
COUNTY ENGINEER
RIGHT OF WAY MAP

FAIRVIEW AVENUE
S.A.P. 62-648-03

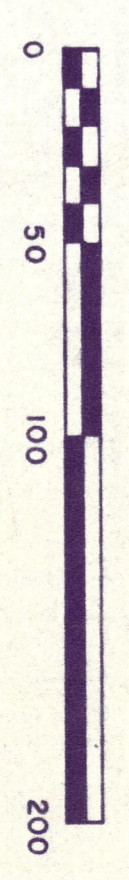

She

LEGEND:
 PROPOSED R/W
 TEMPORARY SLOPE EASEMENT