OFFICE OF COUNTY ENGINEER
RAMSEY COUNTY
MINN.

PAUL N. COATES
COUNTY ENGINEER.

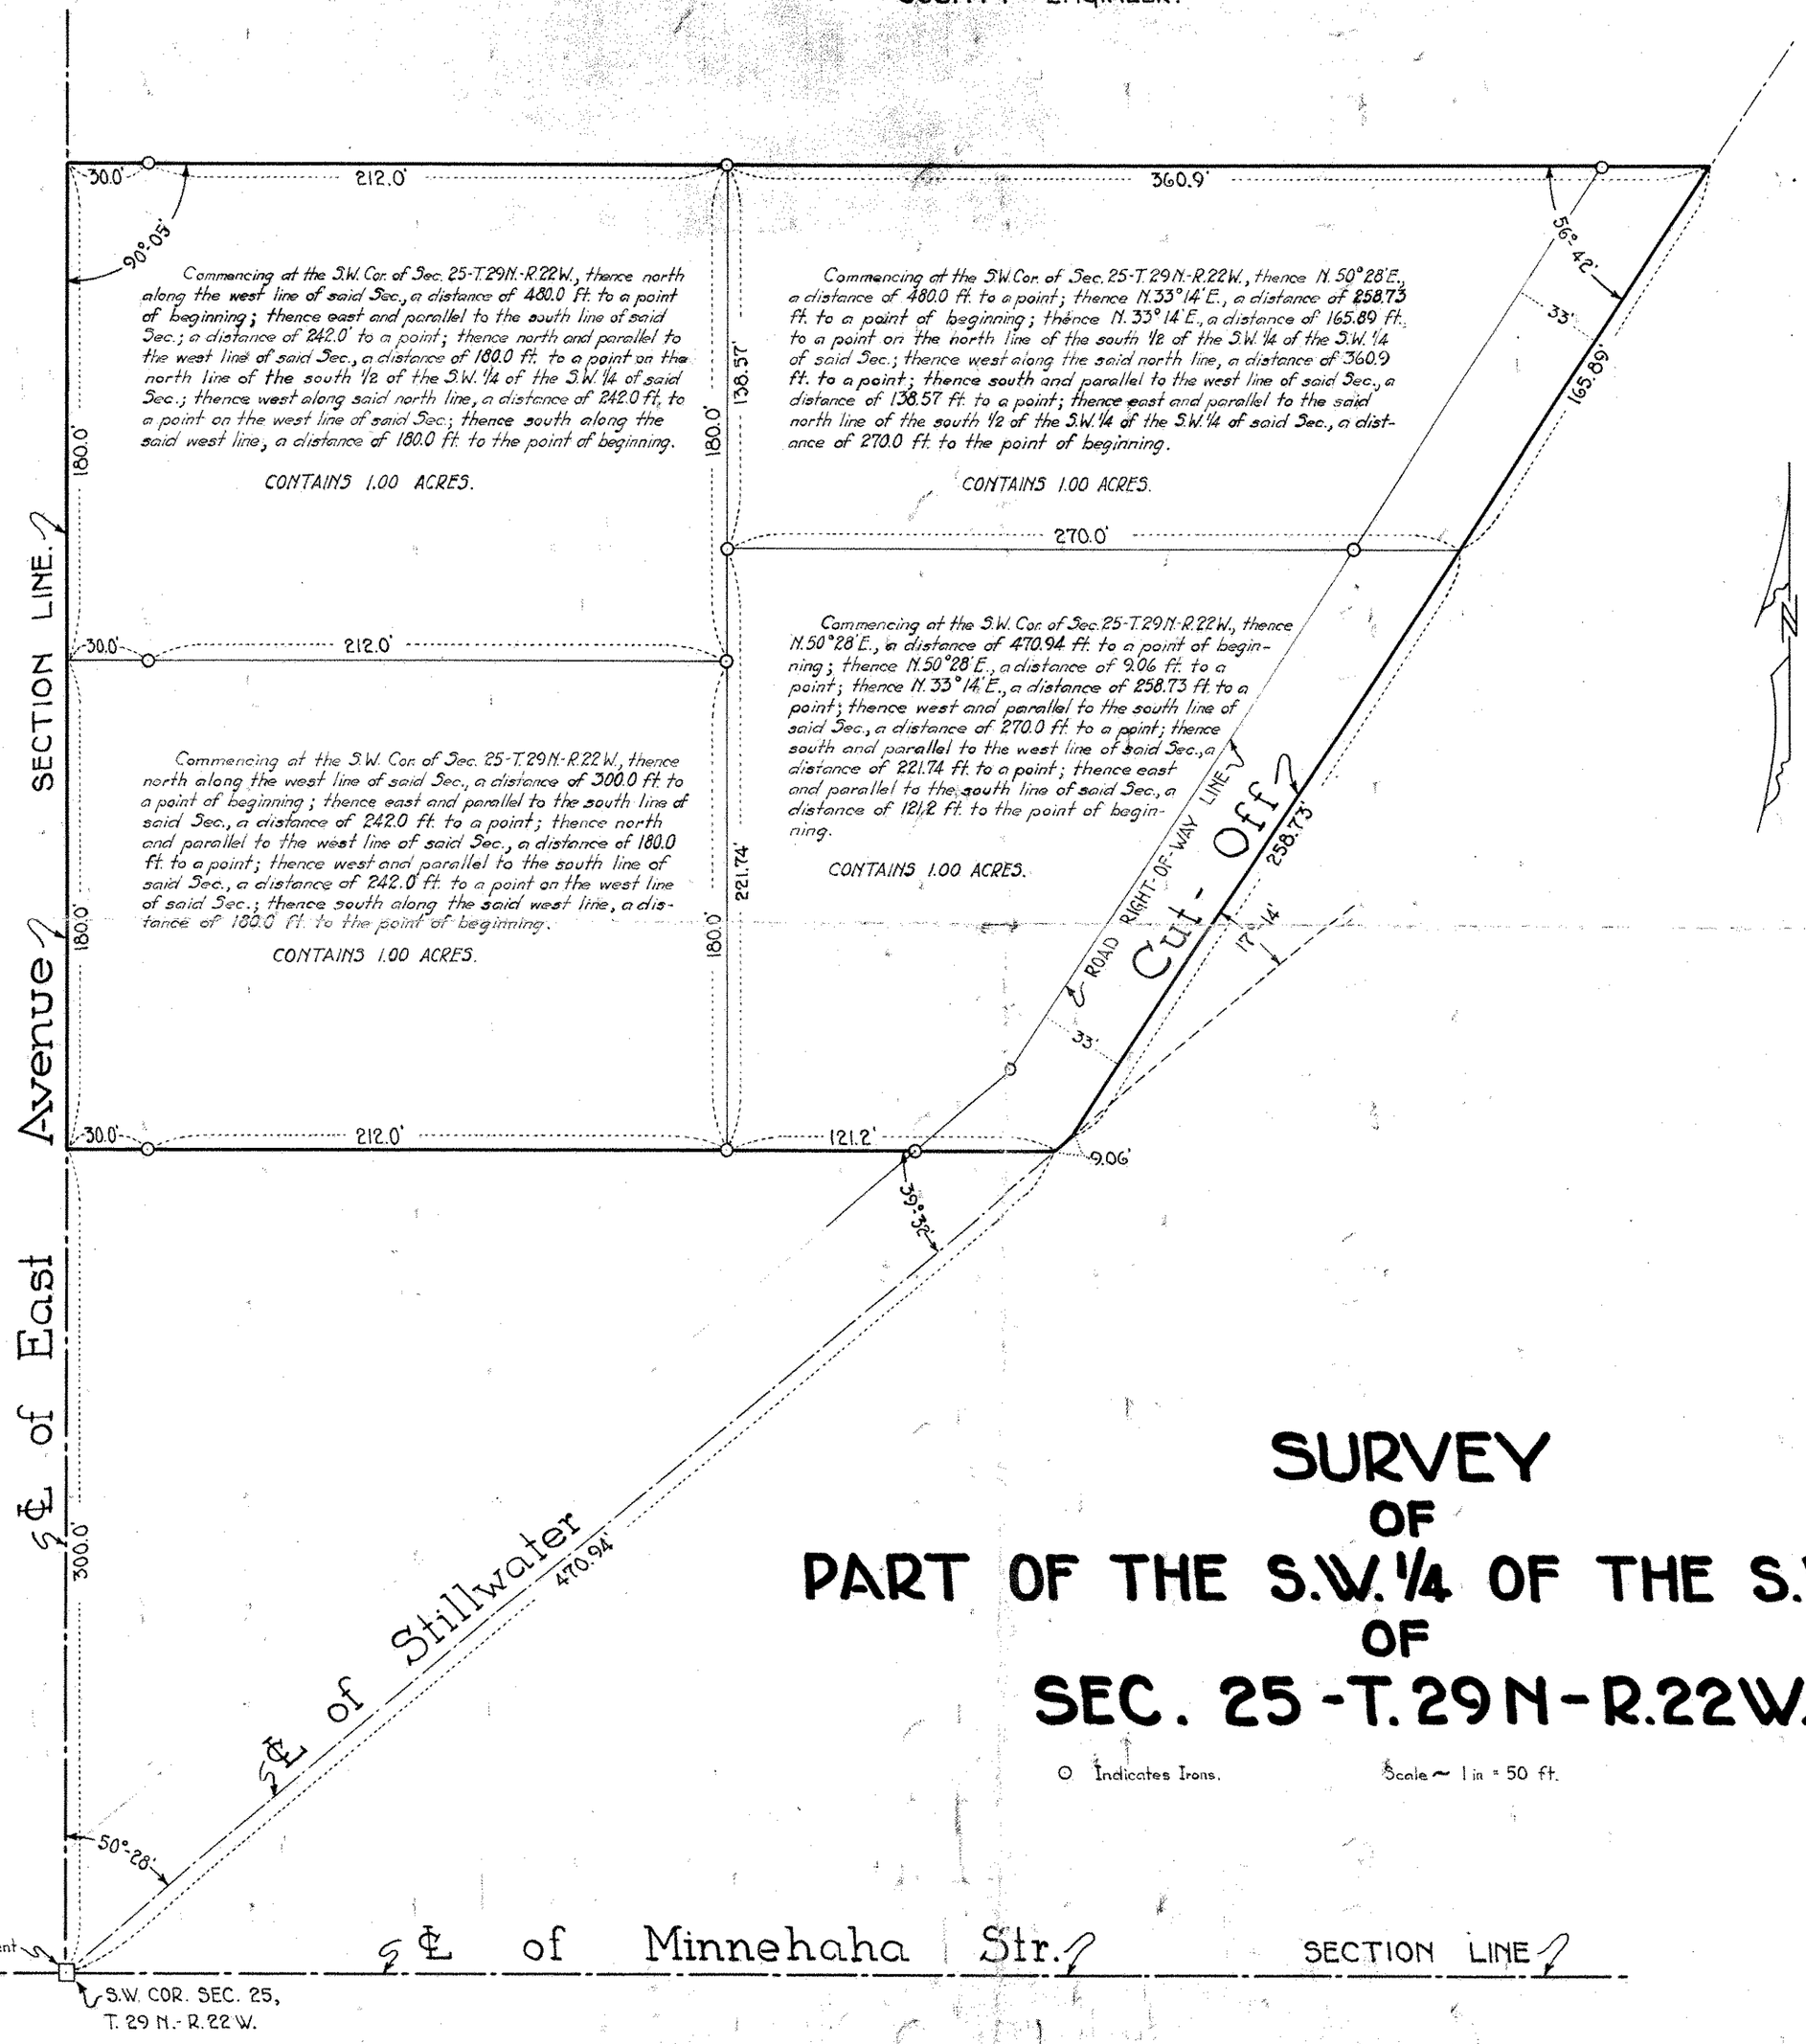

Commencing at the S.W. Cor. of Sec. 25-T.29N.-R.22W., thence north along the west line of said Sec., a distance of 480.0 ft. to a point of beginning; thence east and parallel to the south line of said Sec.; a distance of 242.0' to a point; thence north and parallel to the west line of said Sec., a distance of 180.0 ft. to a point on the north line of the south 1/2 of the S.W. 1/4 of the S.W. 1/4 of said Sec.; thence west along said north line, a distance of 242.0 ft. to a point on the west line of said Sec.; thence south along the said west line, a distance of 180.0 ft. to the point of beginning.

CONTAINS 1.00 ACRES.

Commencing at the S.W. Cor. of Sec. 25-T.29N.-R.22W., thence N. 50°28'E., a distance of 480.0 ft. to a point; thence N.33°14'E., a distance of 258.73 ft. to a point of beginning; thence N. 33°14'E., a distance of 165.89 ft. to a point on the north line of the south 1/2 of the S.W. 1/4 of the S.W. 1/4 of said Sec.; thence west along the said north line, a distance of 360.9 ft. to a point; thence south and parallel to the west line of said Sec., a distance of 138.57 ft. to a point; thence east and parallel to the said north line of the south 1/2 of the S.W. 1/4 of the S.W. 1/4 of said Sec., a distance of 270.0 ft. to the point of beginning.

CONTAINS 1.00 ACRES.

Commencing at the S.W. Cor. of Sec. 25-T.29N.-R.22W., thence north along the west line of said Sec., a distance of 300.0 ft. to a point of beginning; thence east and parallel to the south line of said Sec., a distance of 242.0 ft. to a point; thence north and parallel to the west line of said Sec., a distance of 180.0 ft. to a point; thence west and parallel to the south line of said Sec., a distance of 242.0' ft. to a point on the west line of said Sec.; thence south along the said west line, a distance of 180.0 ft. to the point of beginning.

CONTAINS 1.00 ACRES.

Commencing at the S.W. Cor. of Sec. 25-T.29N.-R.22W., thence N.50°28'E., a distance of 470.94 ft. to a point of beginning; thence N.50°28'E., a distance of 9.06 ft. to a point; thence N.33°14'E., a distance of 258.73 ft. to a point; thence west and parallel to the south line of said Sec., a distance of 270.0 ft. to a point; thence south and parallel to the west line of said Sec., a distance of 221.74 ft. to a point; thence east and parallel to the south line of said Sec., a distance of 121.2 ft. to the point of beginning.

CONTAINS 1.00 ACRES.

SURVEY
OF
PART OF THE S.W. 1/4 OF THE S.W. 1/4
OF
SEC. 25 - T. 29 N - R. 22 W.

O Indicates Irons.

Scale ~ 1 in = 50 ft.

H.R.P.