

MOUNDS VIEW TOWNSHIP

3583 RICE STREET, ST. PAUL 6, MINN.


RAMSEY COUNTY, MINNESOTA

Irvine L. Bucher, Clerk

TELEPHONE: IV. 4-2034

All that part lying westerly of centerline of Hodgson Rd. of following north 988 ft. of NE 1/4 of Sec. 24, T 30, R 23; except the N 1/2 of NW 1/4 of said NE 1/4 and also except the north 236. 04 ft. of S 1/2 of NW 1/4 of said NE 1/4, all subject to Hodgson Rd.

HODGSON RD TH 49

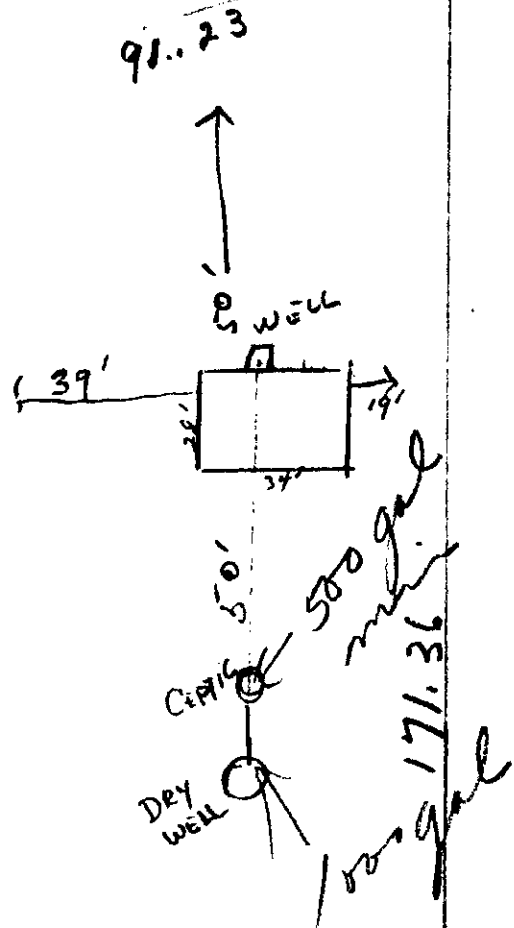

143.45

256.04

71.14