Certificate of Survey

From the office of

GEORGE SCHMIDT & ASSOC. INC.

3092 No. Lexington Ave., Roseville, Mn. 55113

LAND SURVEYING

483-4408

I Hereby Certify that this plat shows a survey made by me of the property described on this plat, and that the corners are correctly placed as shown, and that all locations have been correctly shown.

Job Number: _____

Surveyed For _____

Date _____

Scale _____

By _____

REGISTERED LAND SURVEYOR

At A – 0° to South

– to B N ~~52~~ 52° 29' W (221.87')
(~~120°~~ 127°31')

to 2 – N 33°45'30" W (155.75')
(146°14'30")

to 1 – N 19°12'58" W (91.15')
(160°47'02")

At B – S 52°29'E to Pt A

to C – N 29°09' W – 256.25
(203°20')

to 3 – N 4°46'10" W (89.60')
(227°12'50")

to 2 – S 86 23 52 E (89.60') (326°05'08")

At C – S 29°09'E to B

to 4 – ~~N~~ 150°04'19" W 102.87'
(209°04'41")

to 5 – N 0°04'19" W 304.17
(209°04'41")

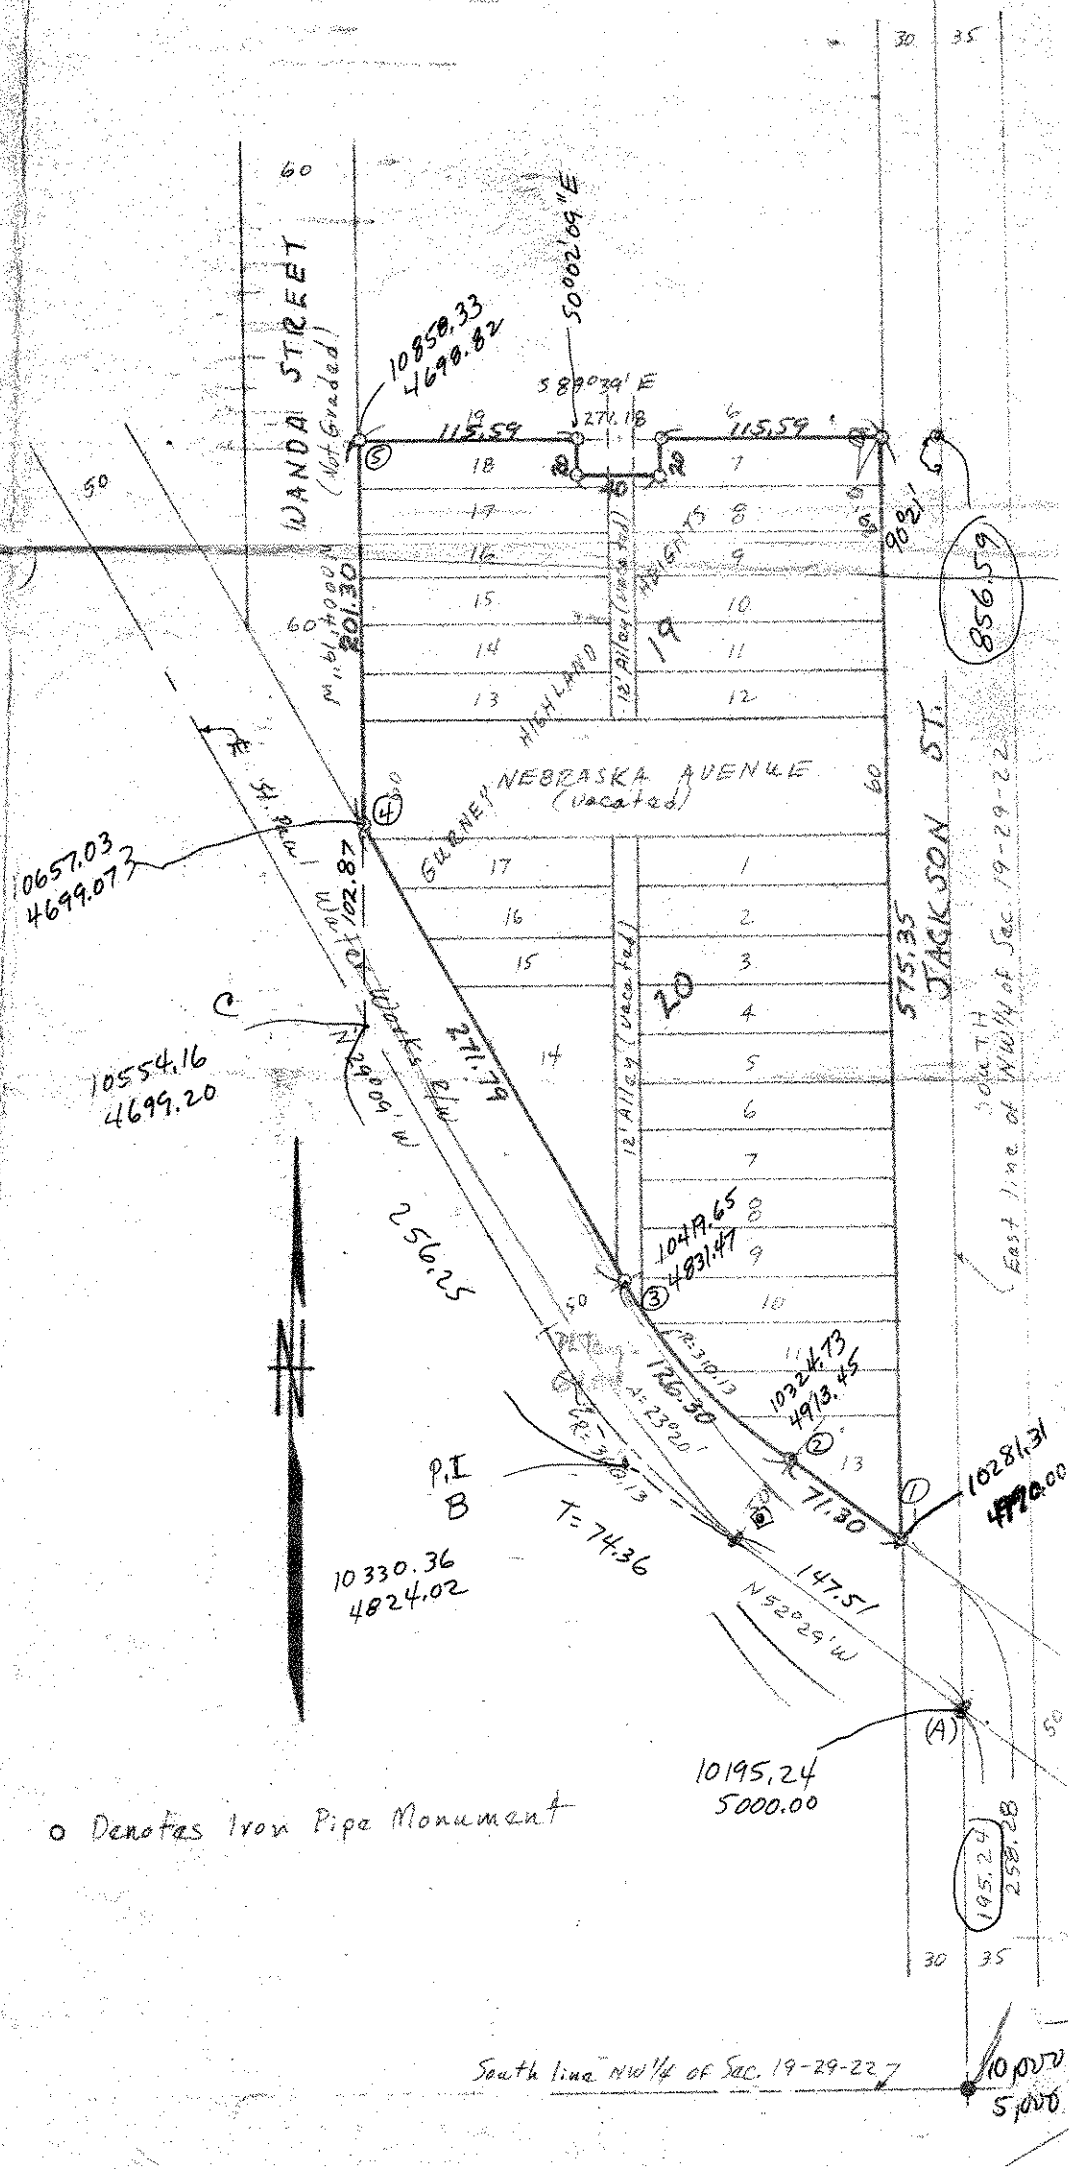

o Denotes Iron Pipe Monument