


LL961-0

DRAINAGE SURVEY OF LOTS 1-2 BLK. 2 WEED & HALLE'S ADDITION

FILE: LEGAL DEPT. P.H.C. in Vault No.

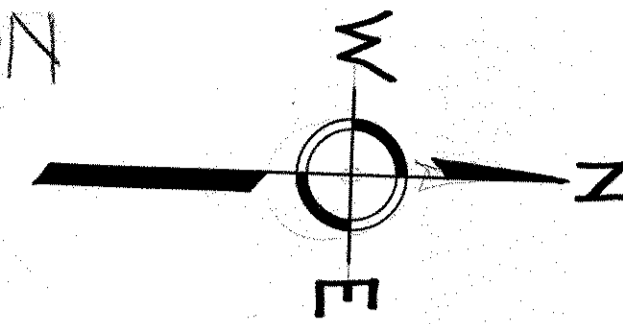


SCALE: 1" = 10'

Book 1167


P.H. "C"

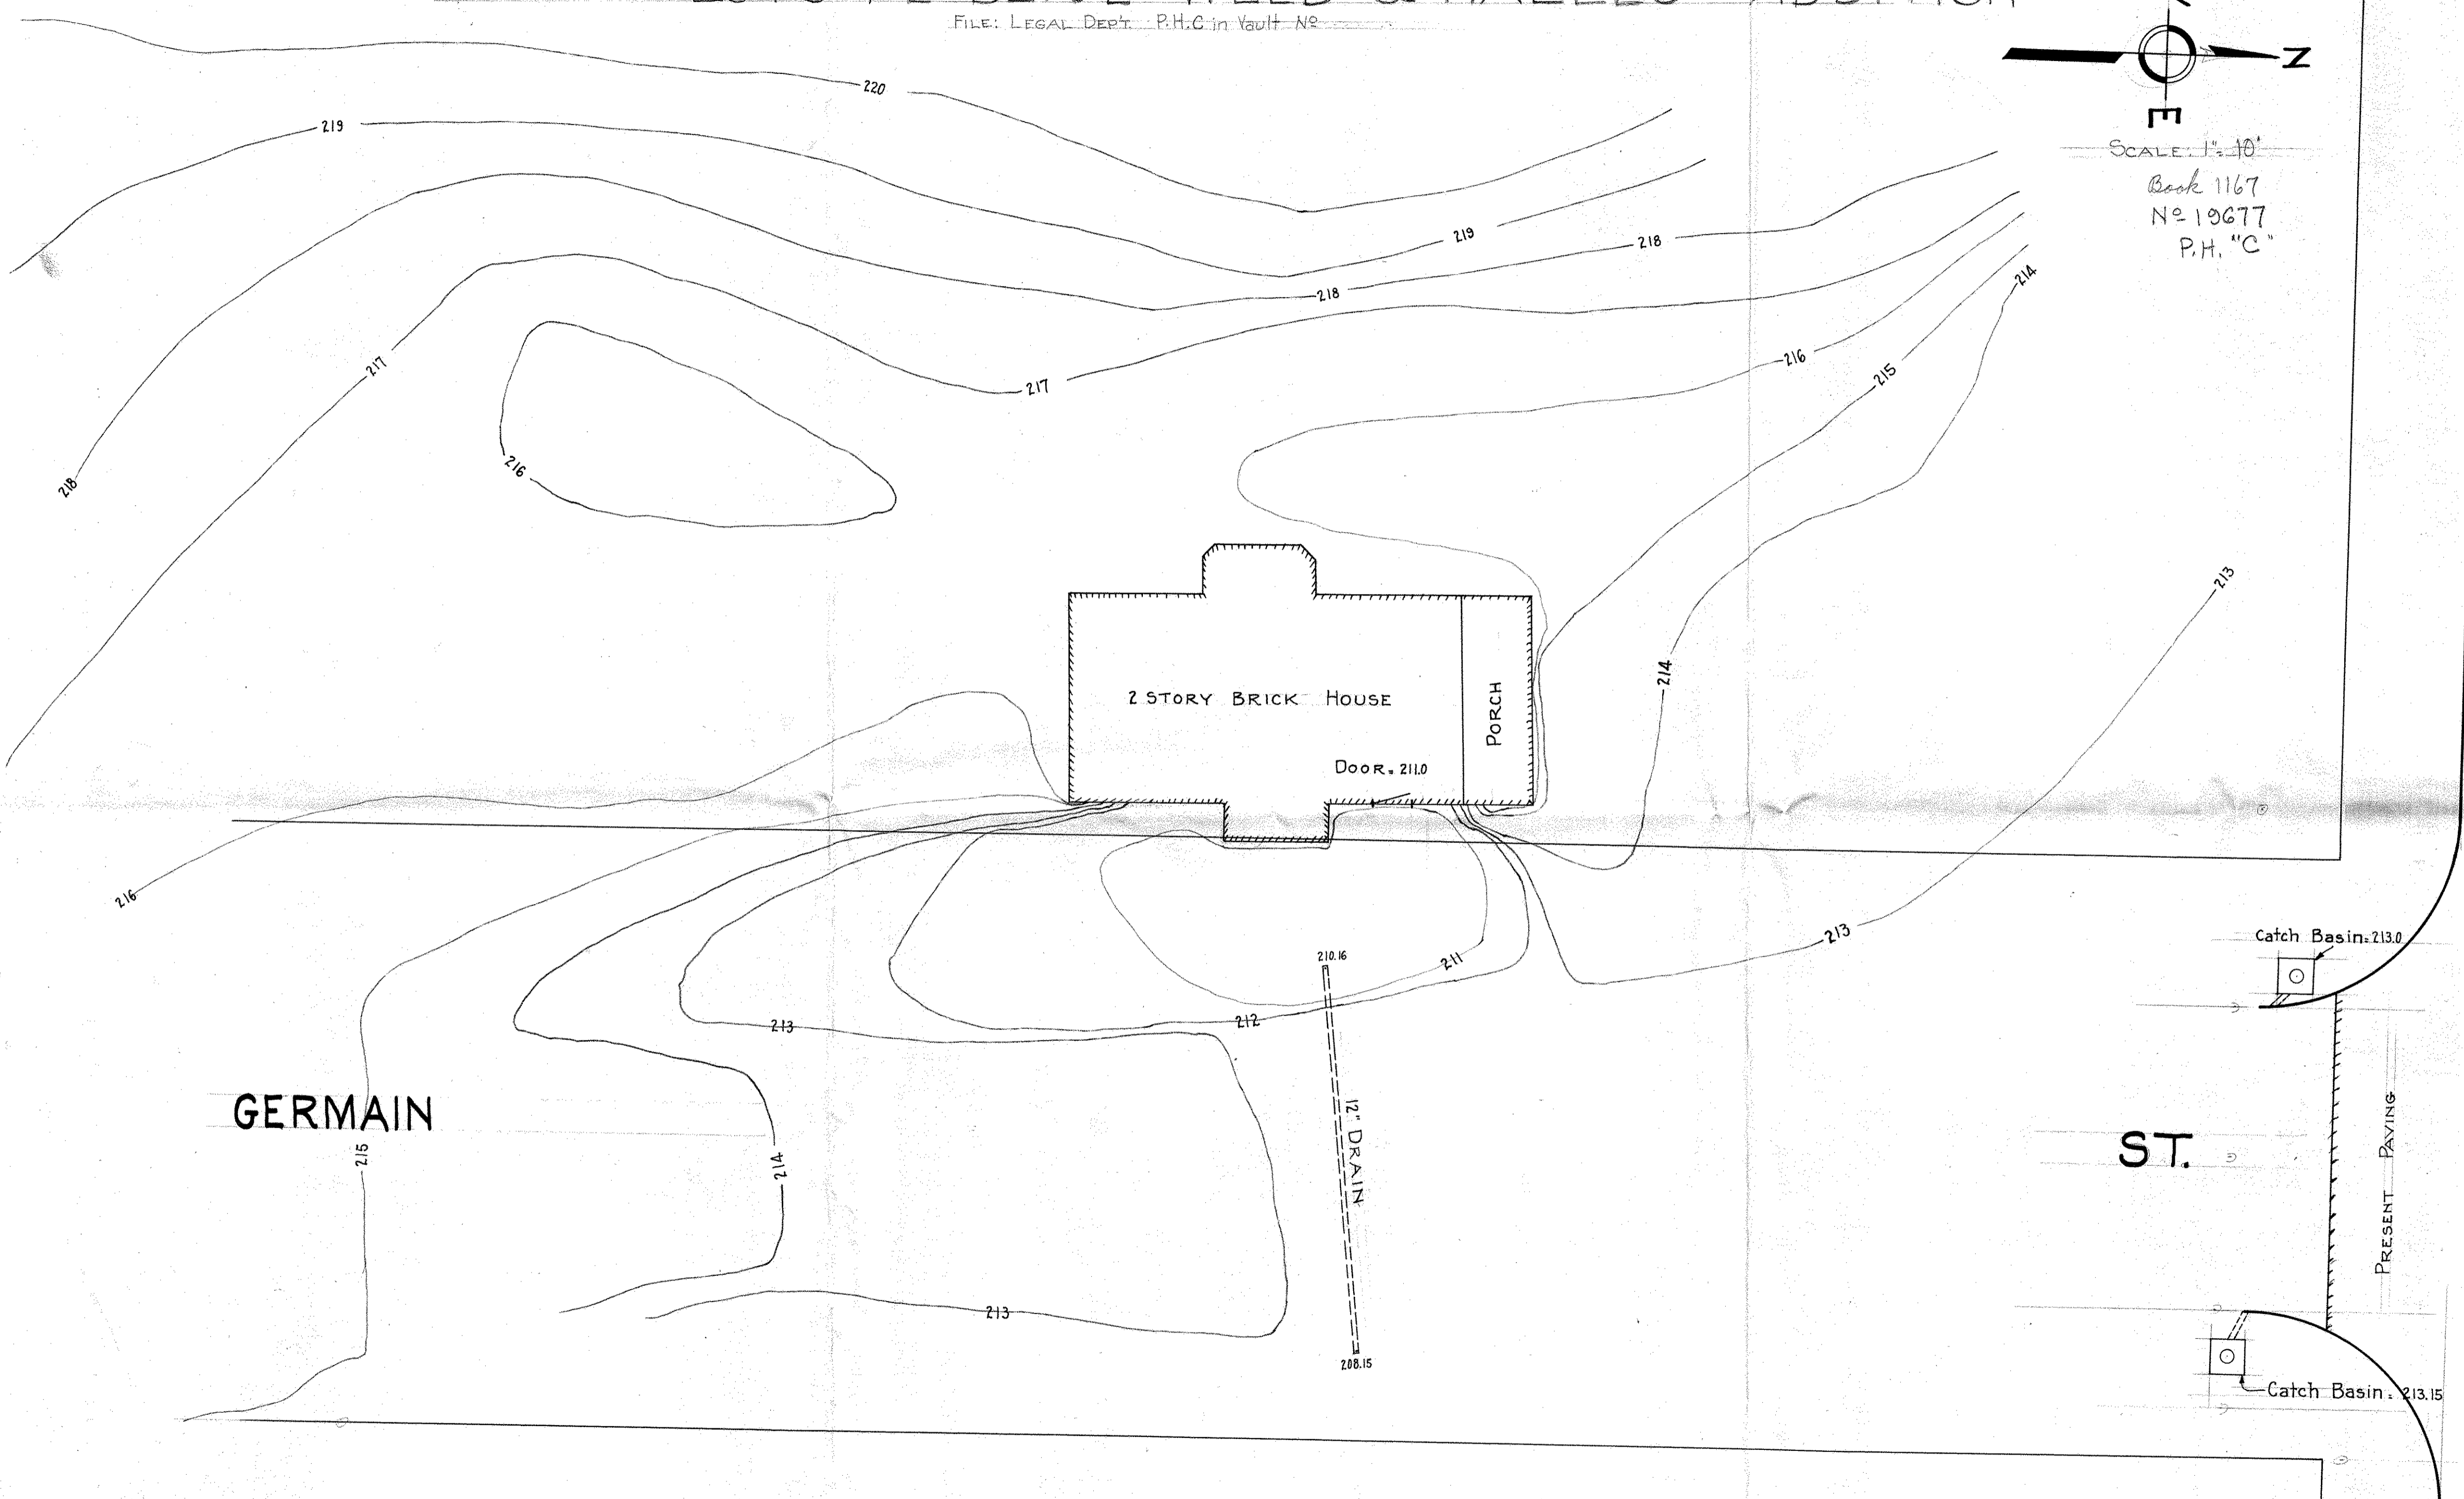

2 STORY BRICK HOUSE

PORCH

Door. 211.0

210.16

208.15

Catch Basin. 213.0

Catch Basin. 213.15

PRESENT PAVING

GERMAIN

ST.

MINNEHAHA

ST.