


State St

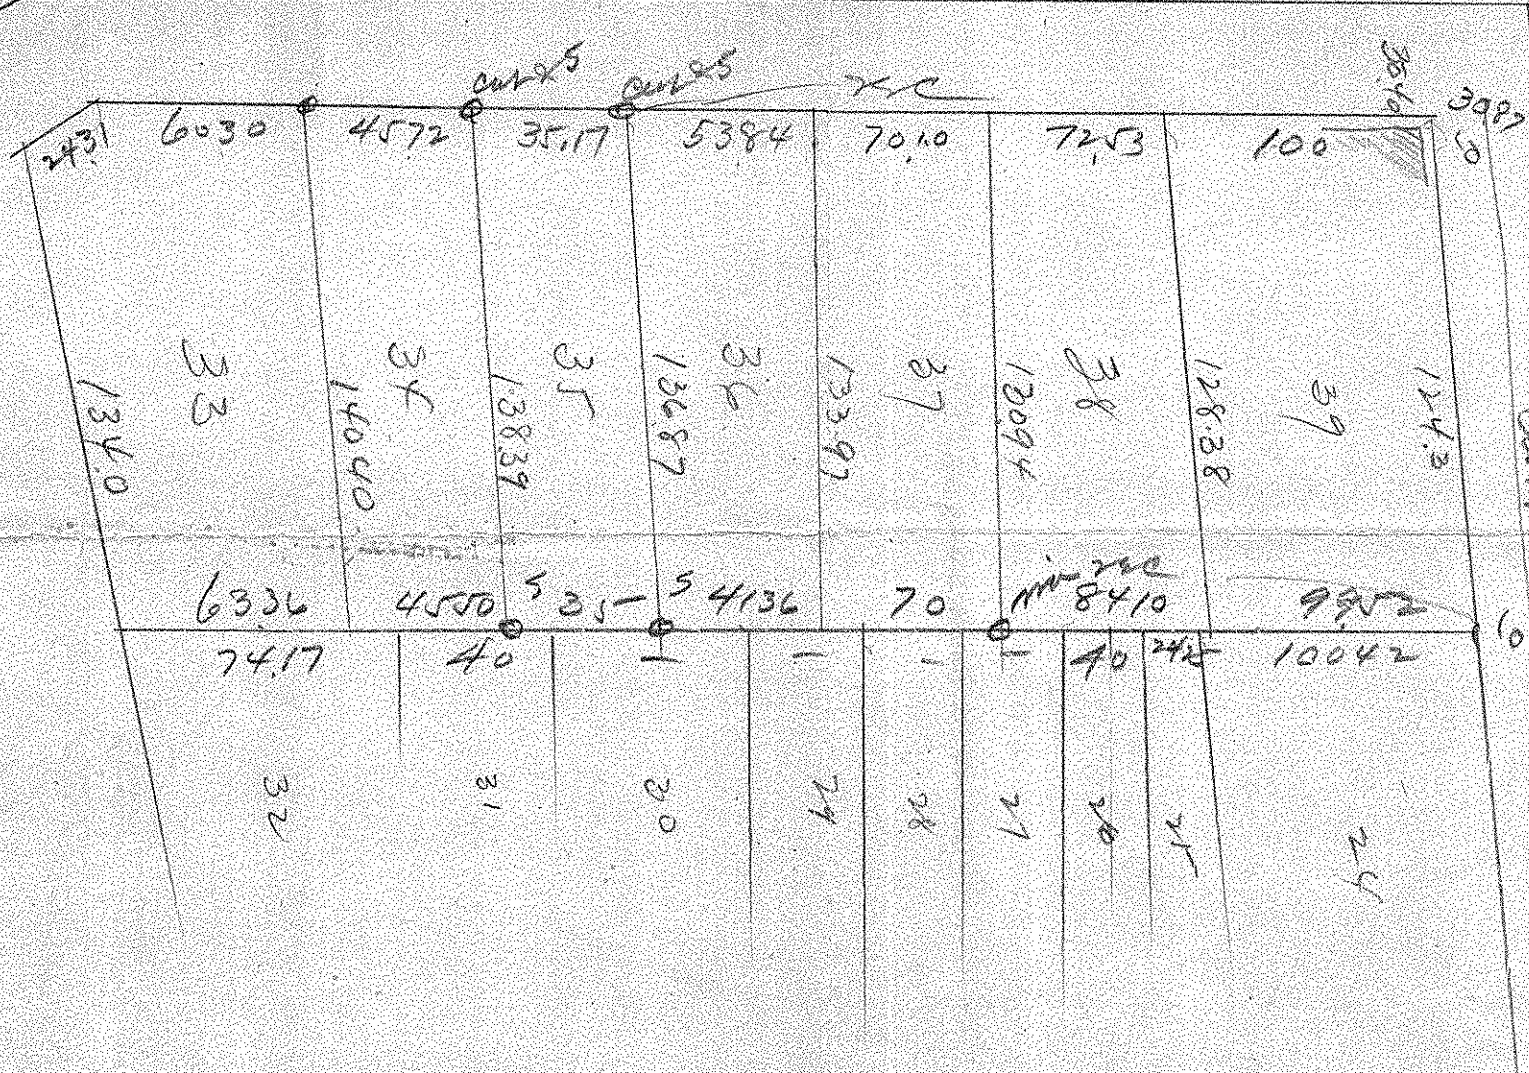

Leonard St

Curt