


This Surveyed  
 Lands Subdivided  
 Location and Street Grades  
 Estimated Made  
 Platting and Blue Printing  
 Surveys for Law Suits  
 Drainage Surveys  
 Topographical Surveys

JOHN B. IRVING  
 CIVIL ENGINEER AND SURVEYOR

ROOM 408 GLOBE BUILDING

Franklin

ST. PAUL, MINN.

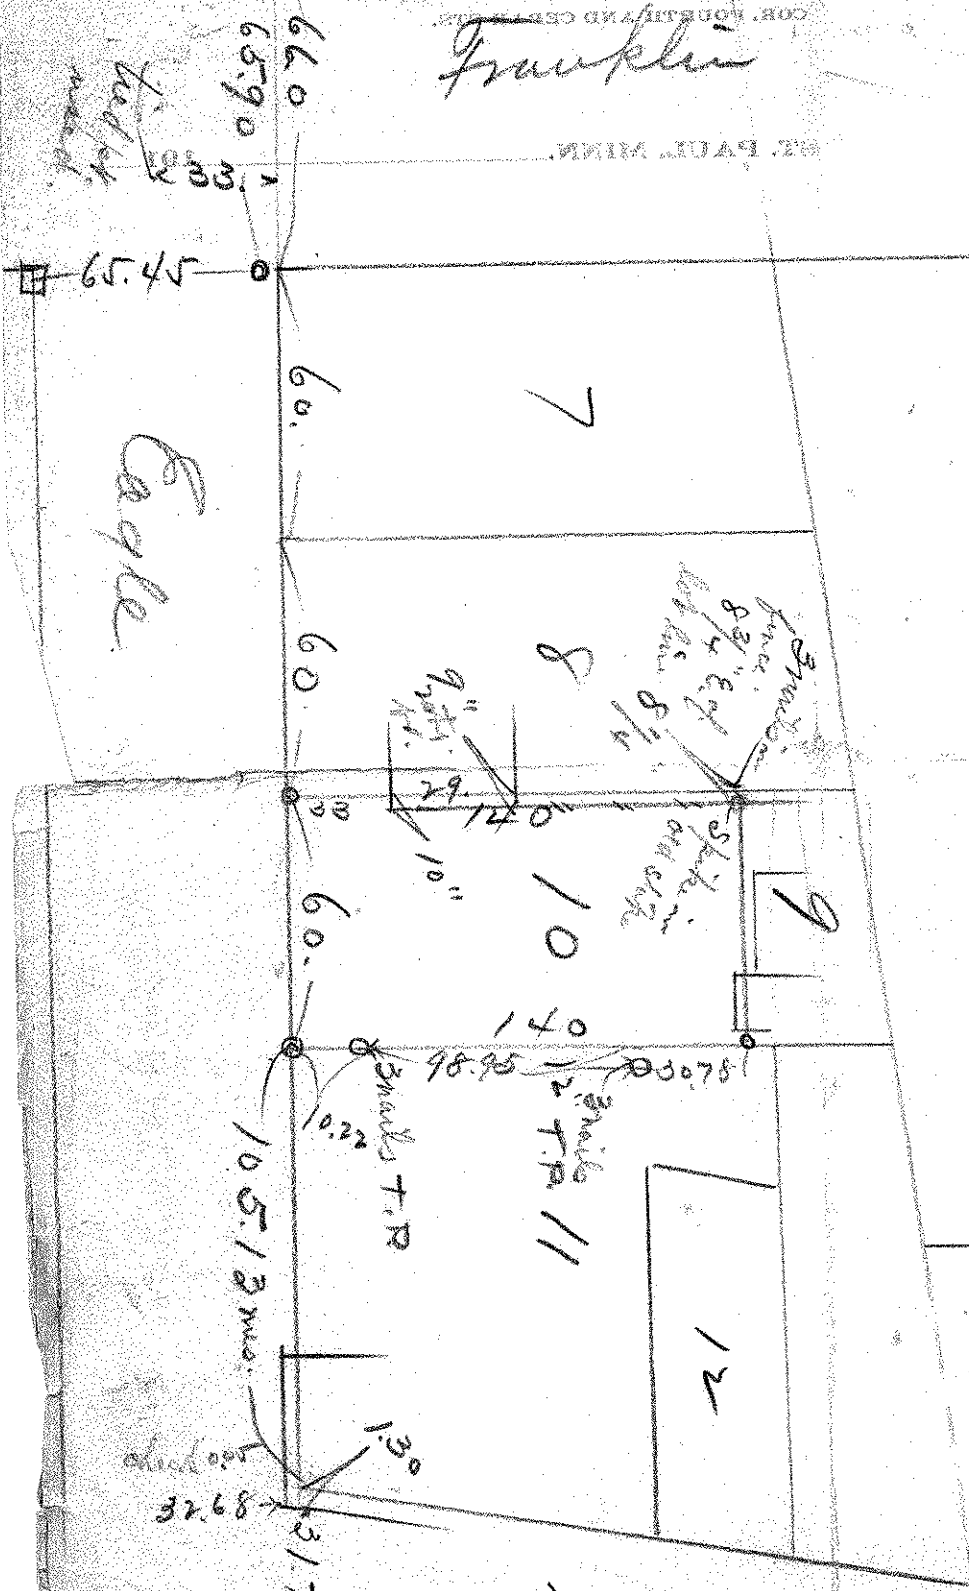

Boyle

Washington

33  
 height used