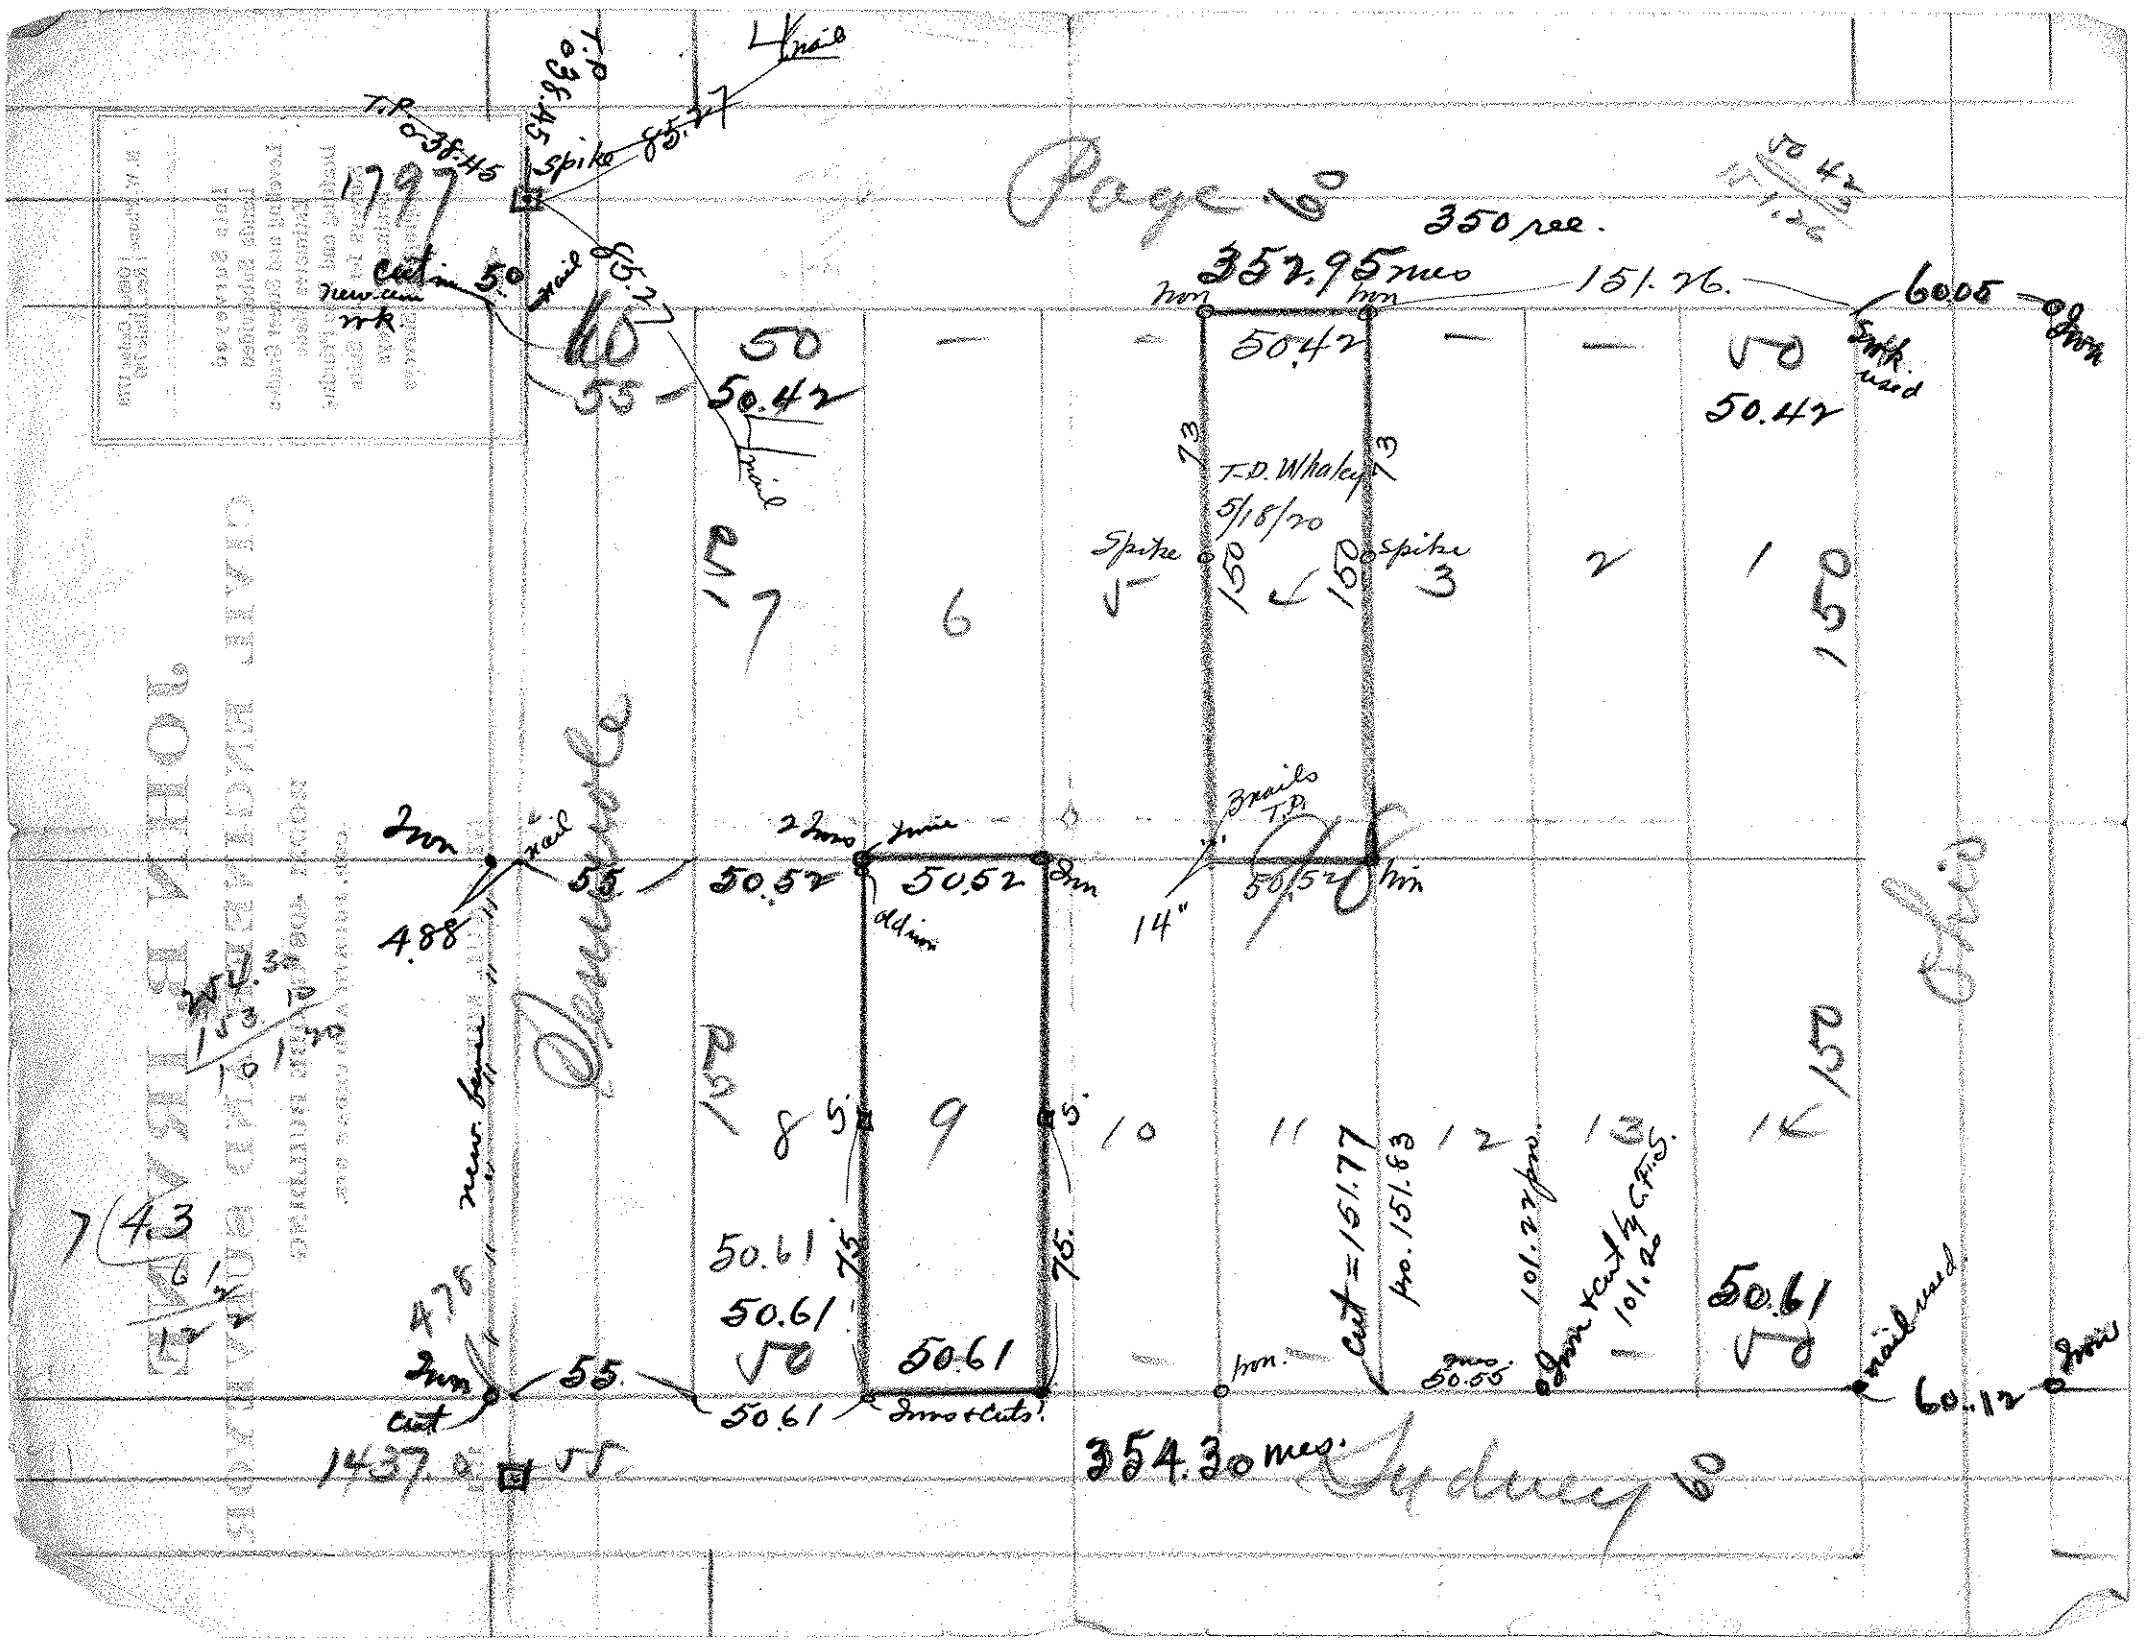
Page 10
350 ree.
352.95 mea
151.76.
6006
50.42
50.42
50.42