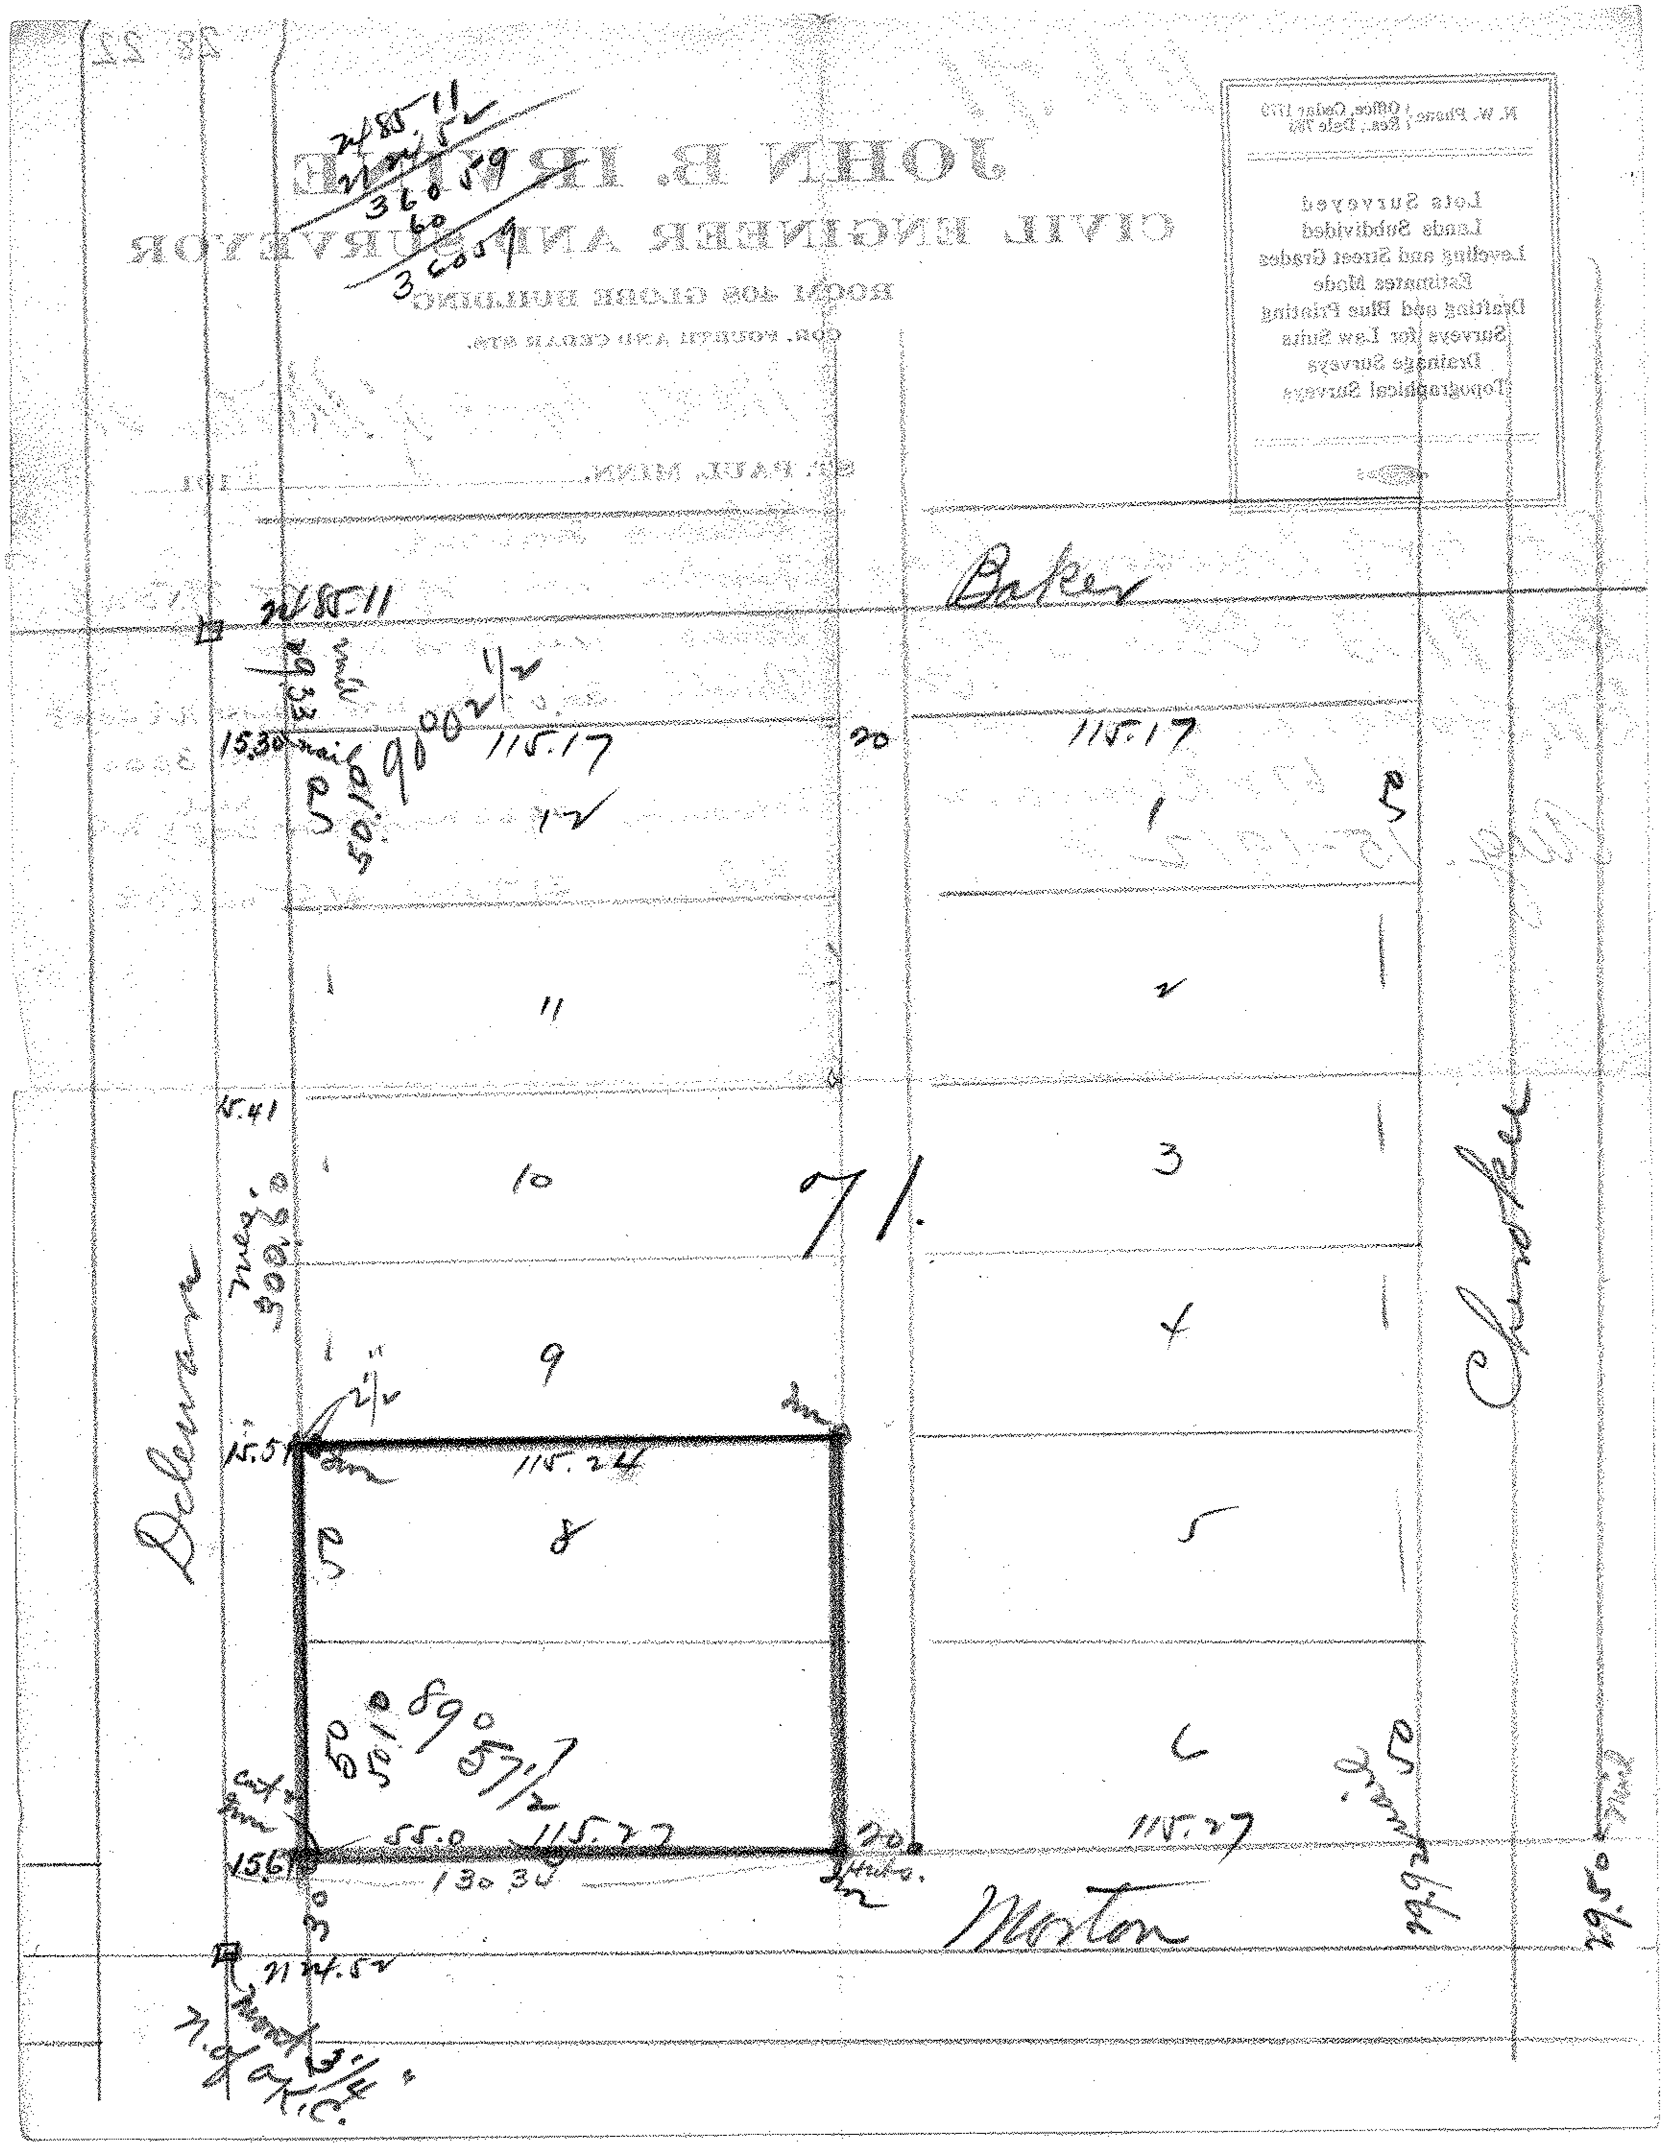

Baker
Delaware
Morton
Cherokee
71.
N 85.11
360.59
60
300.59
90°02½
115.17
15.30 nail
50.10
50
12
11
10
9
8
1
2
3
4
5
6
15.41
meas. 300.60
15.51
115.24
89°57½
50.10
55.0
115.27
156
130.30
30
N 14.52
20
nail
29.92
29.50