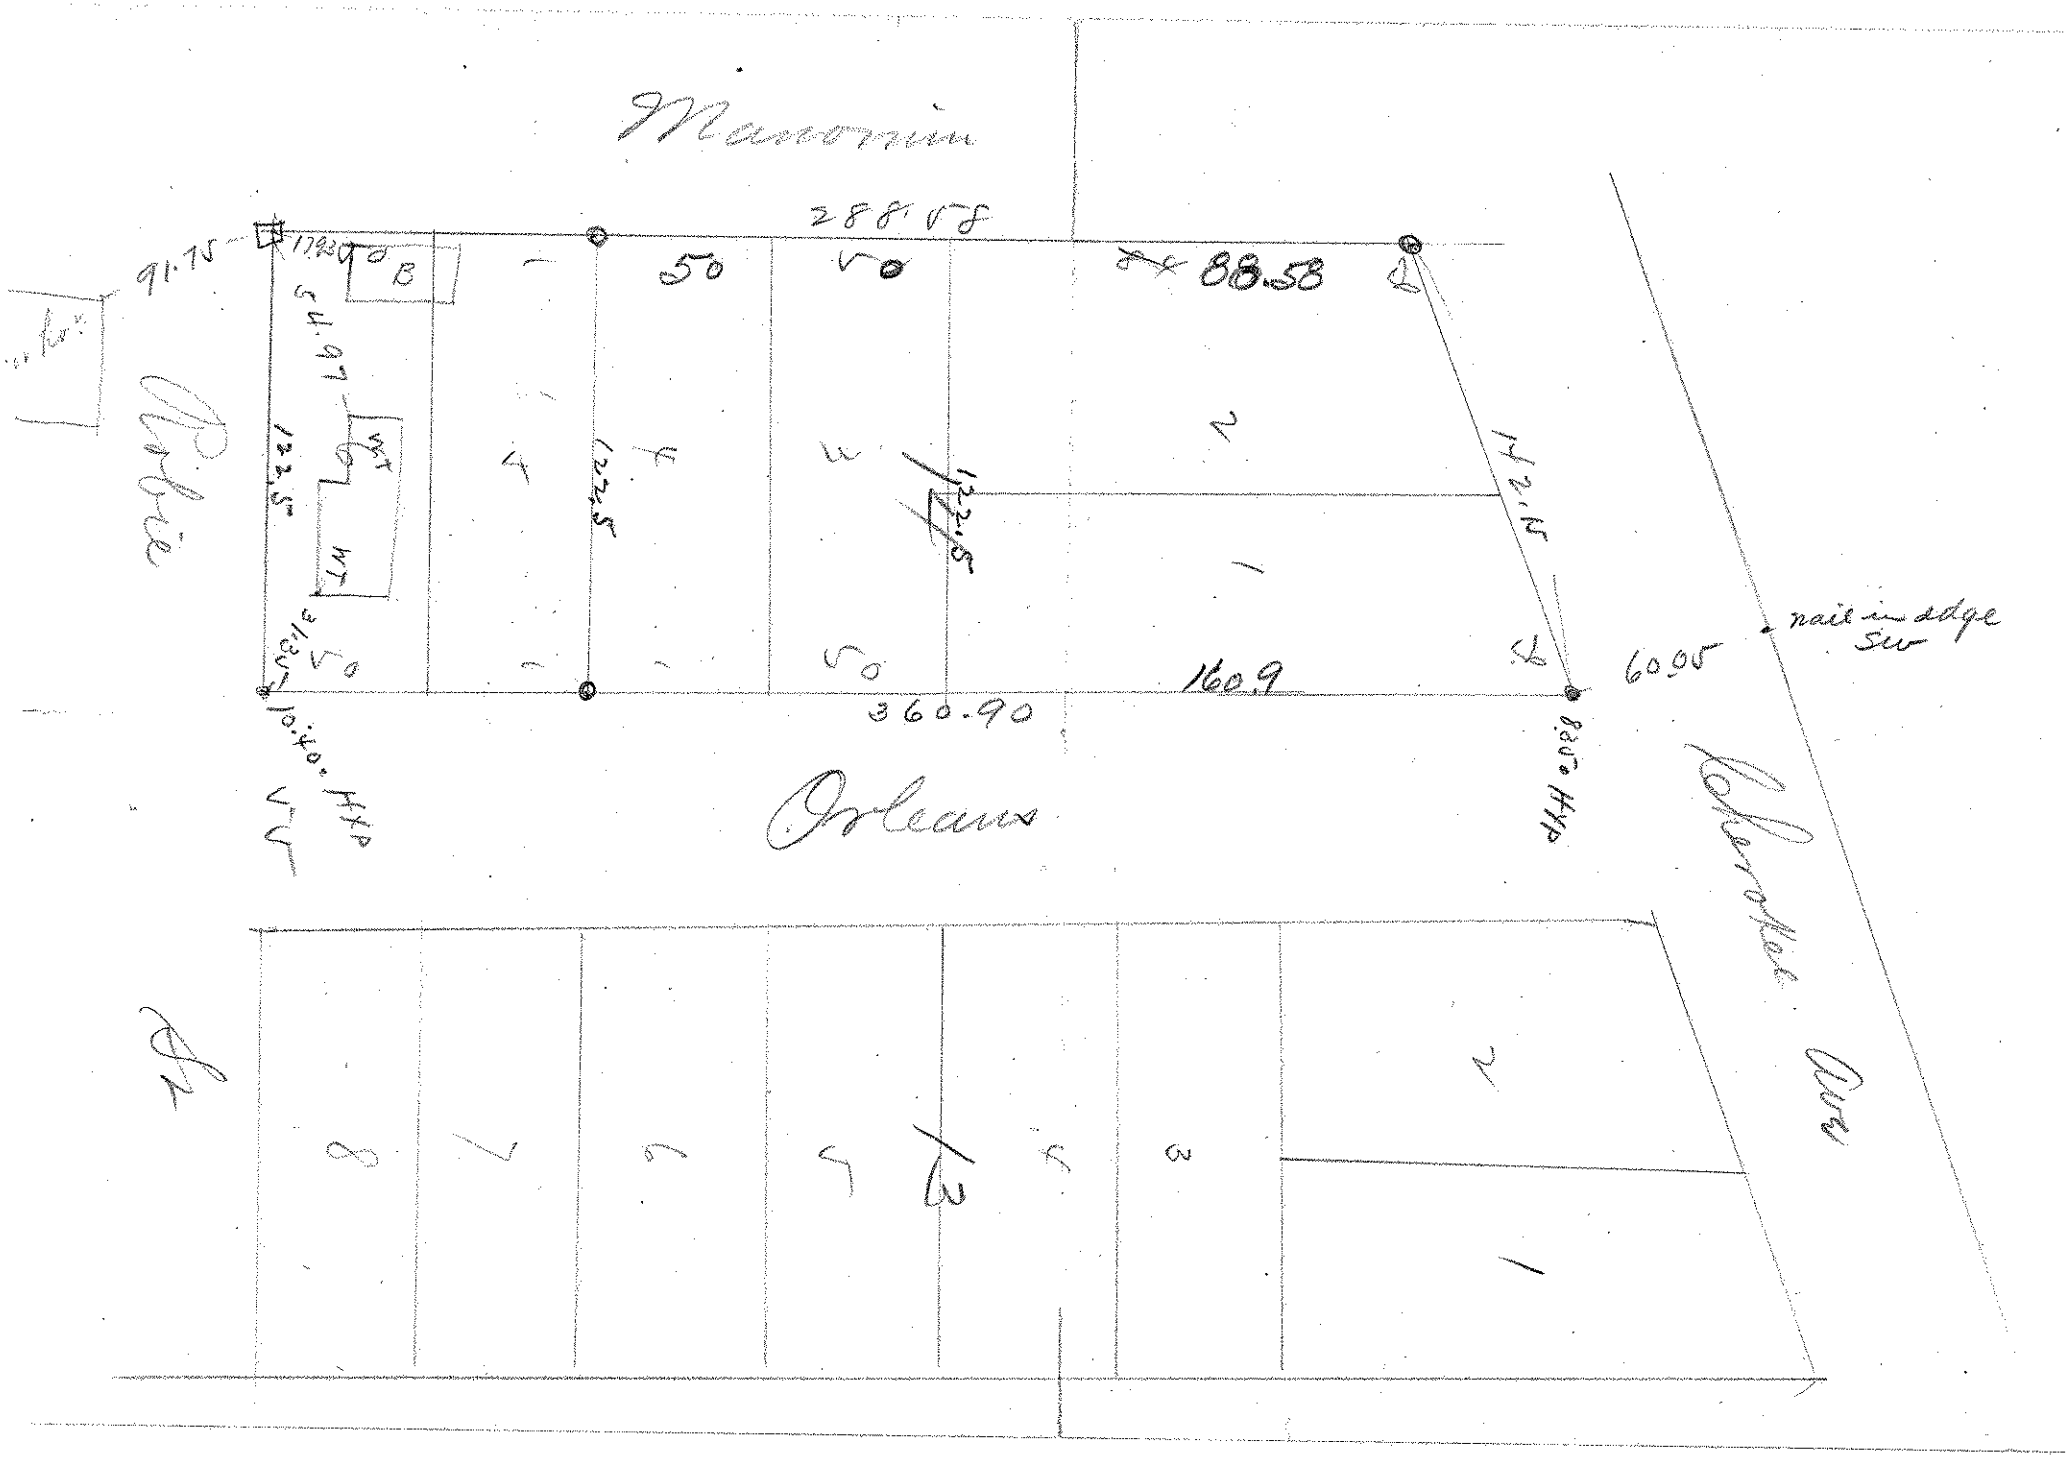
Mancomin
Orleans
288.58
88.58
50
91.75
54.97
122.5
132.5
142.5
160.9
360.90
60.95
10.40 Hyd
8.40 Hyd
nail in edge SW
B
MT
MT
1
2
3
4
5
6
7
8