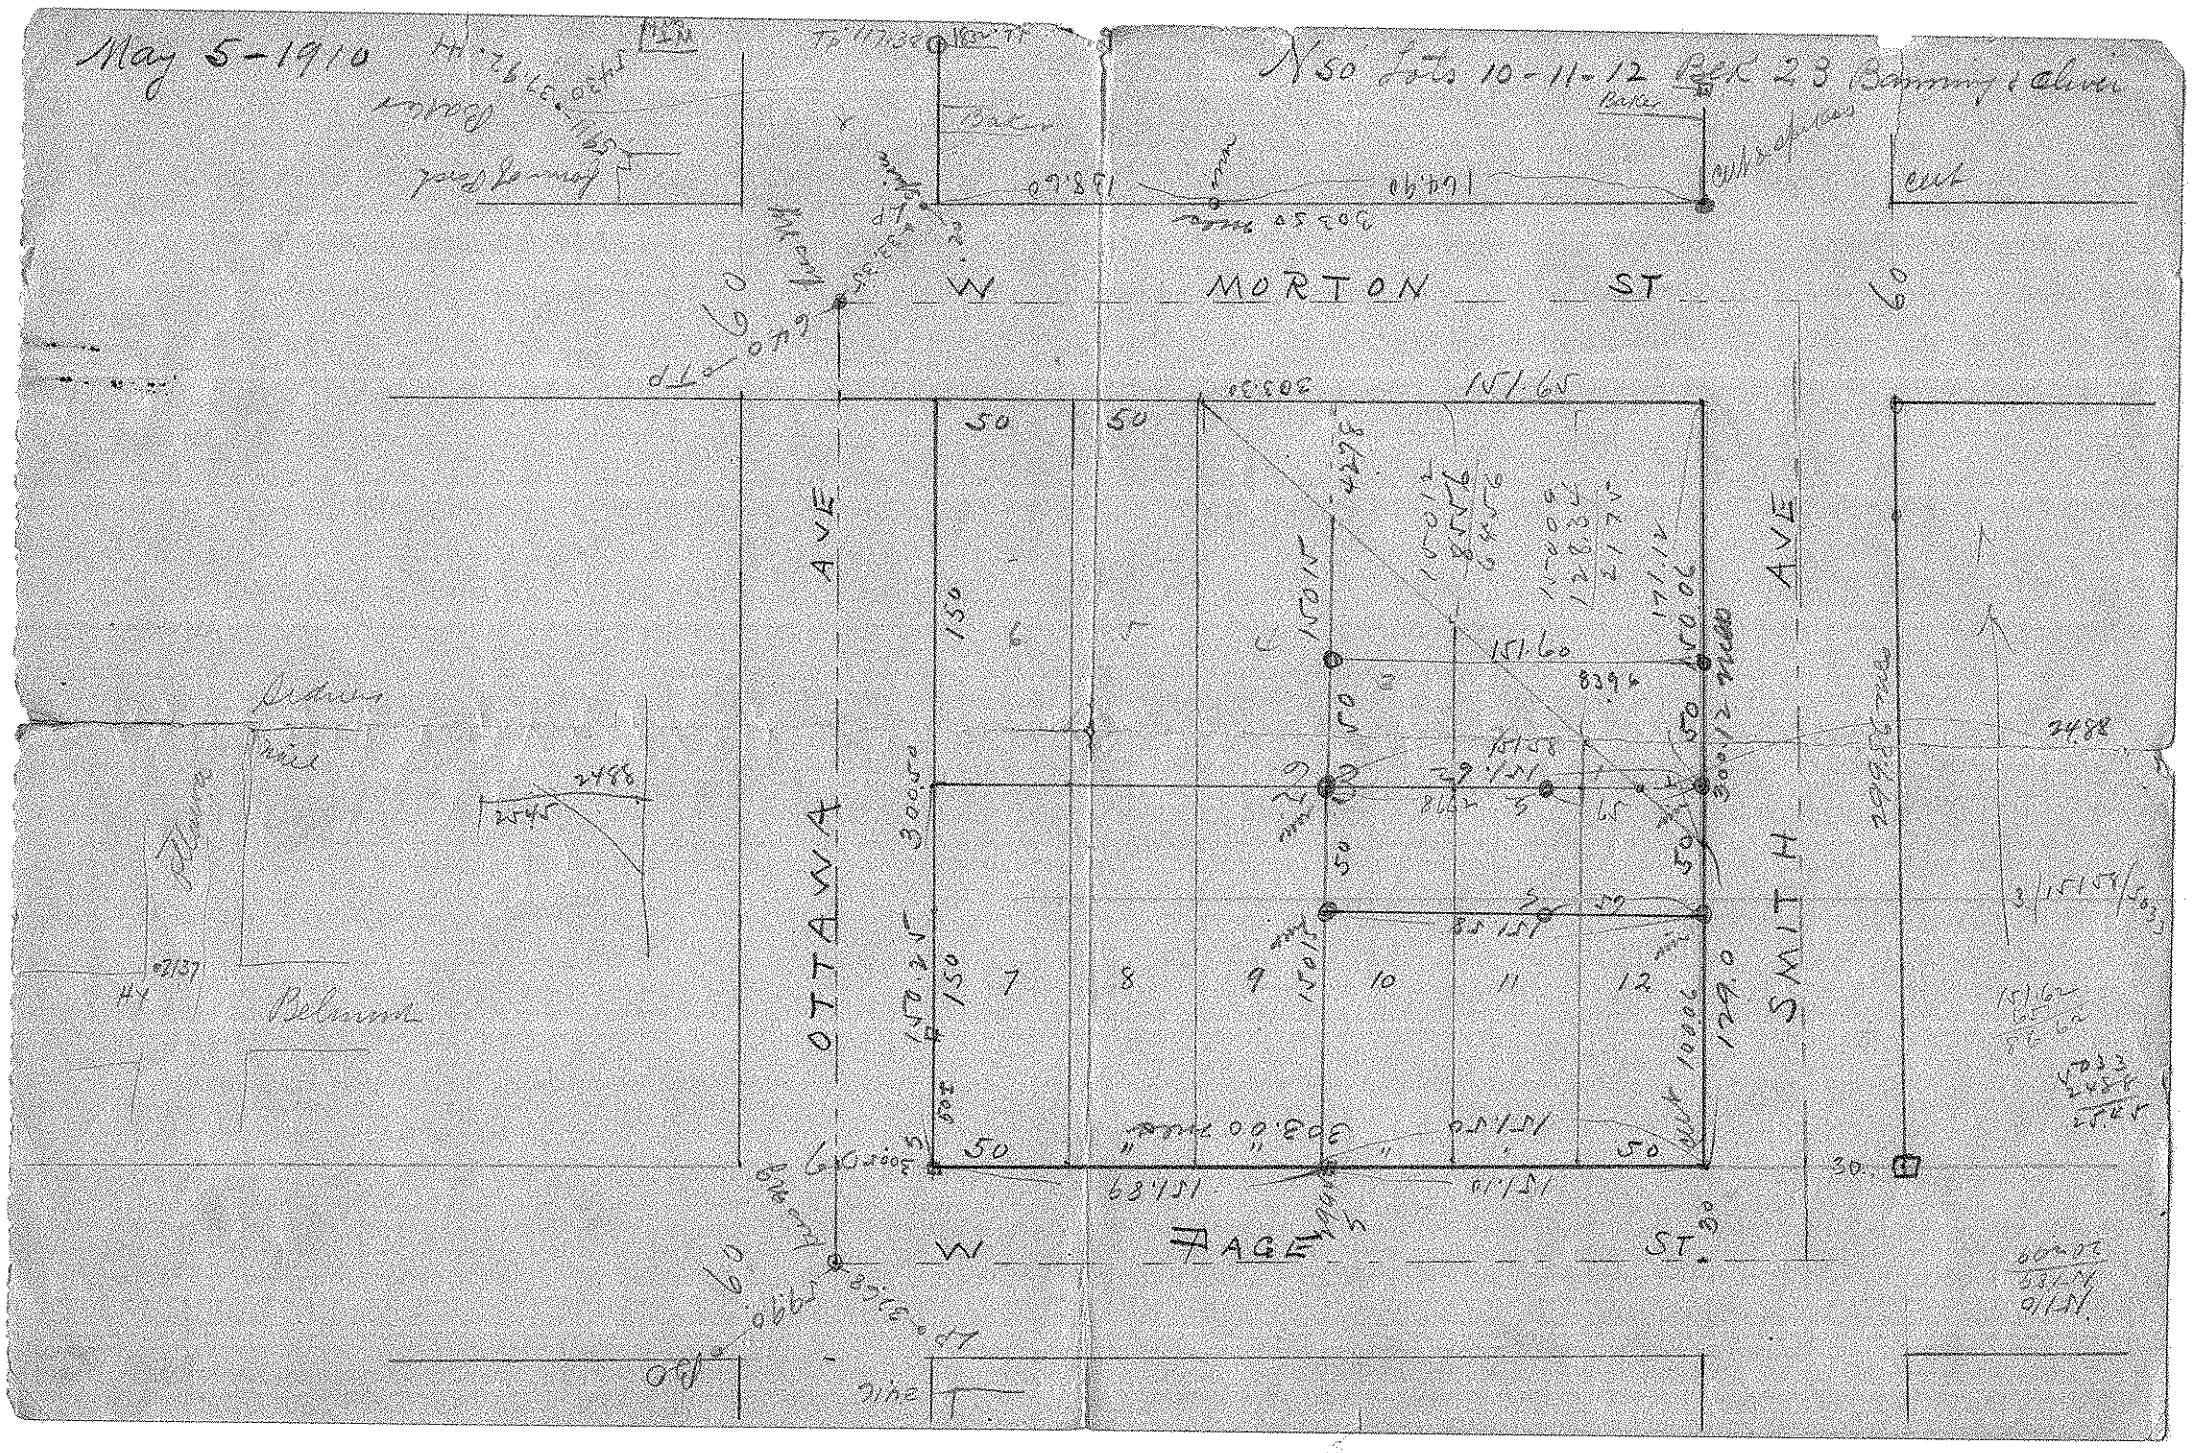
May 5-1910
N 50 Lots 10-11-12 Blk 23 Banning & Oliver
W MORTON ST
OTTAWA AVE
SMITH AVE
W PAGE ST
Baker
Belmont
Sidney
cut
60
50
150
7
8
9
10
11
12
151.60
151.65
151.50
151.89
129.0
2488
2545
30