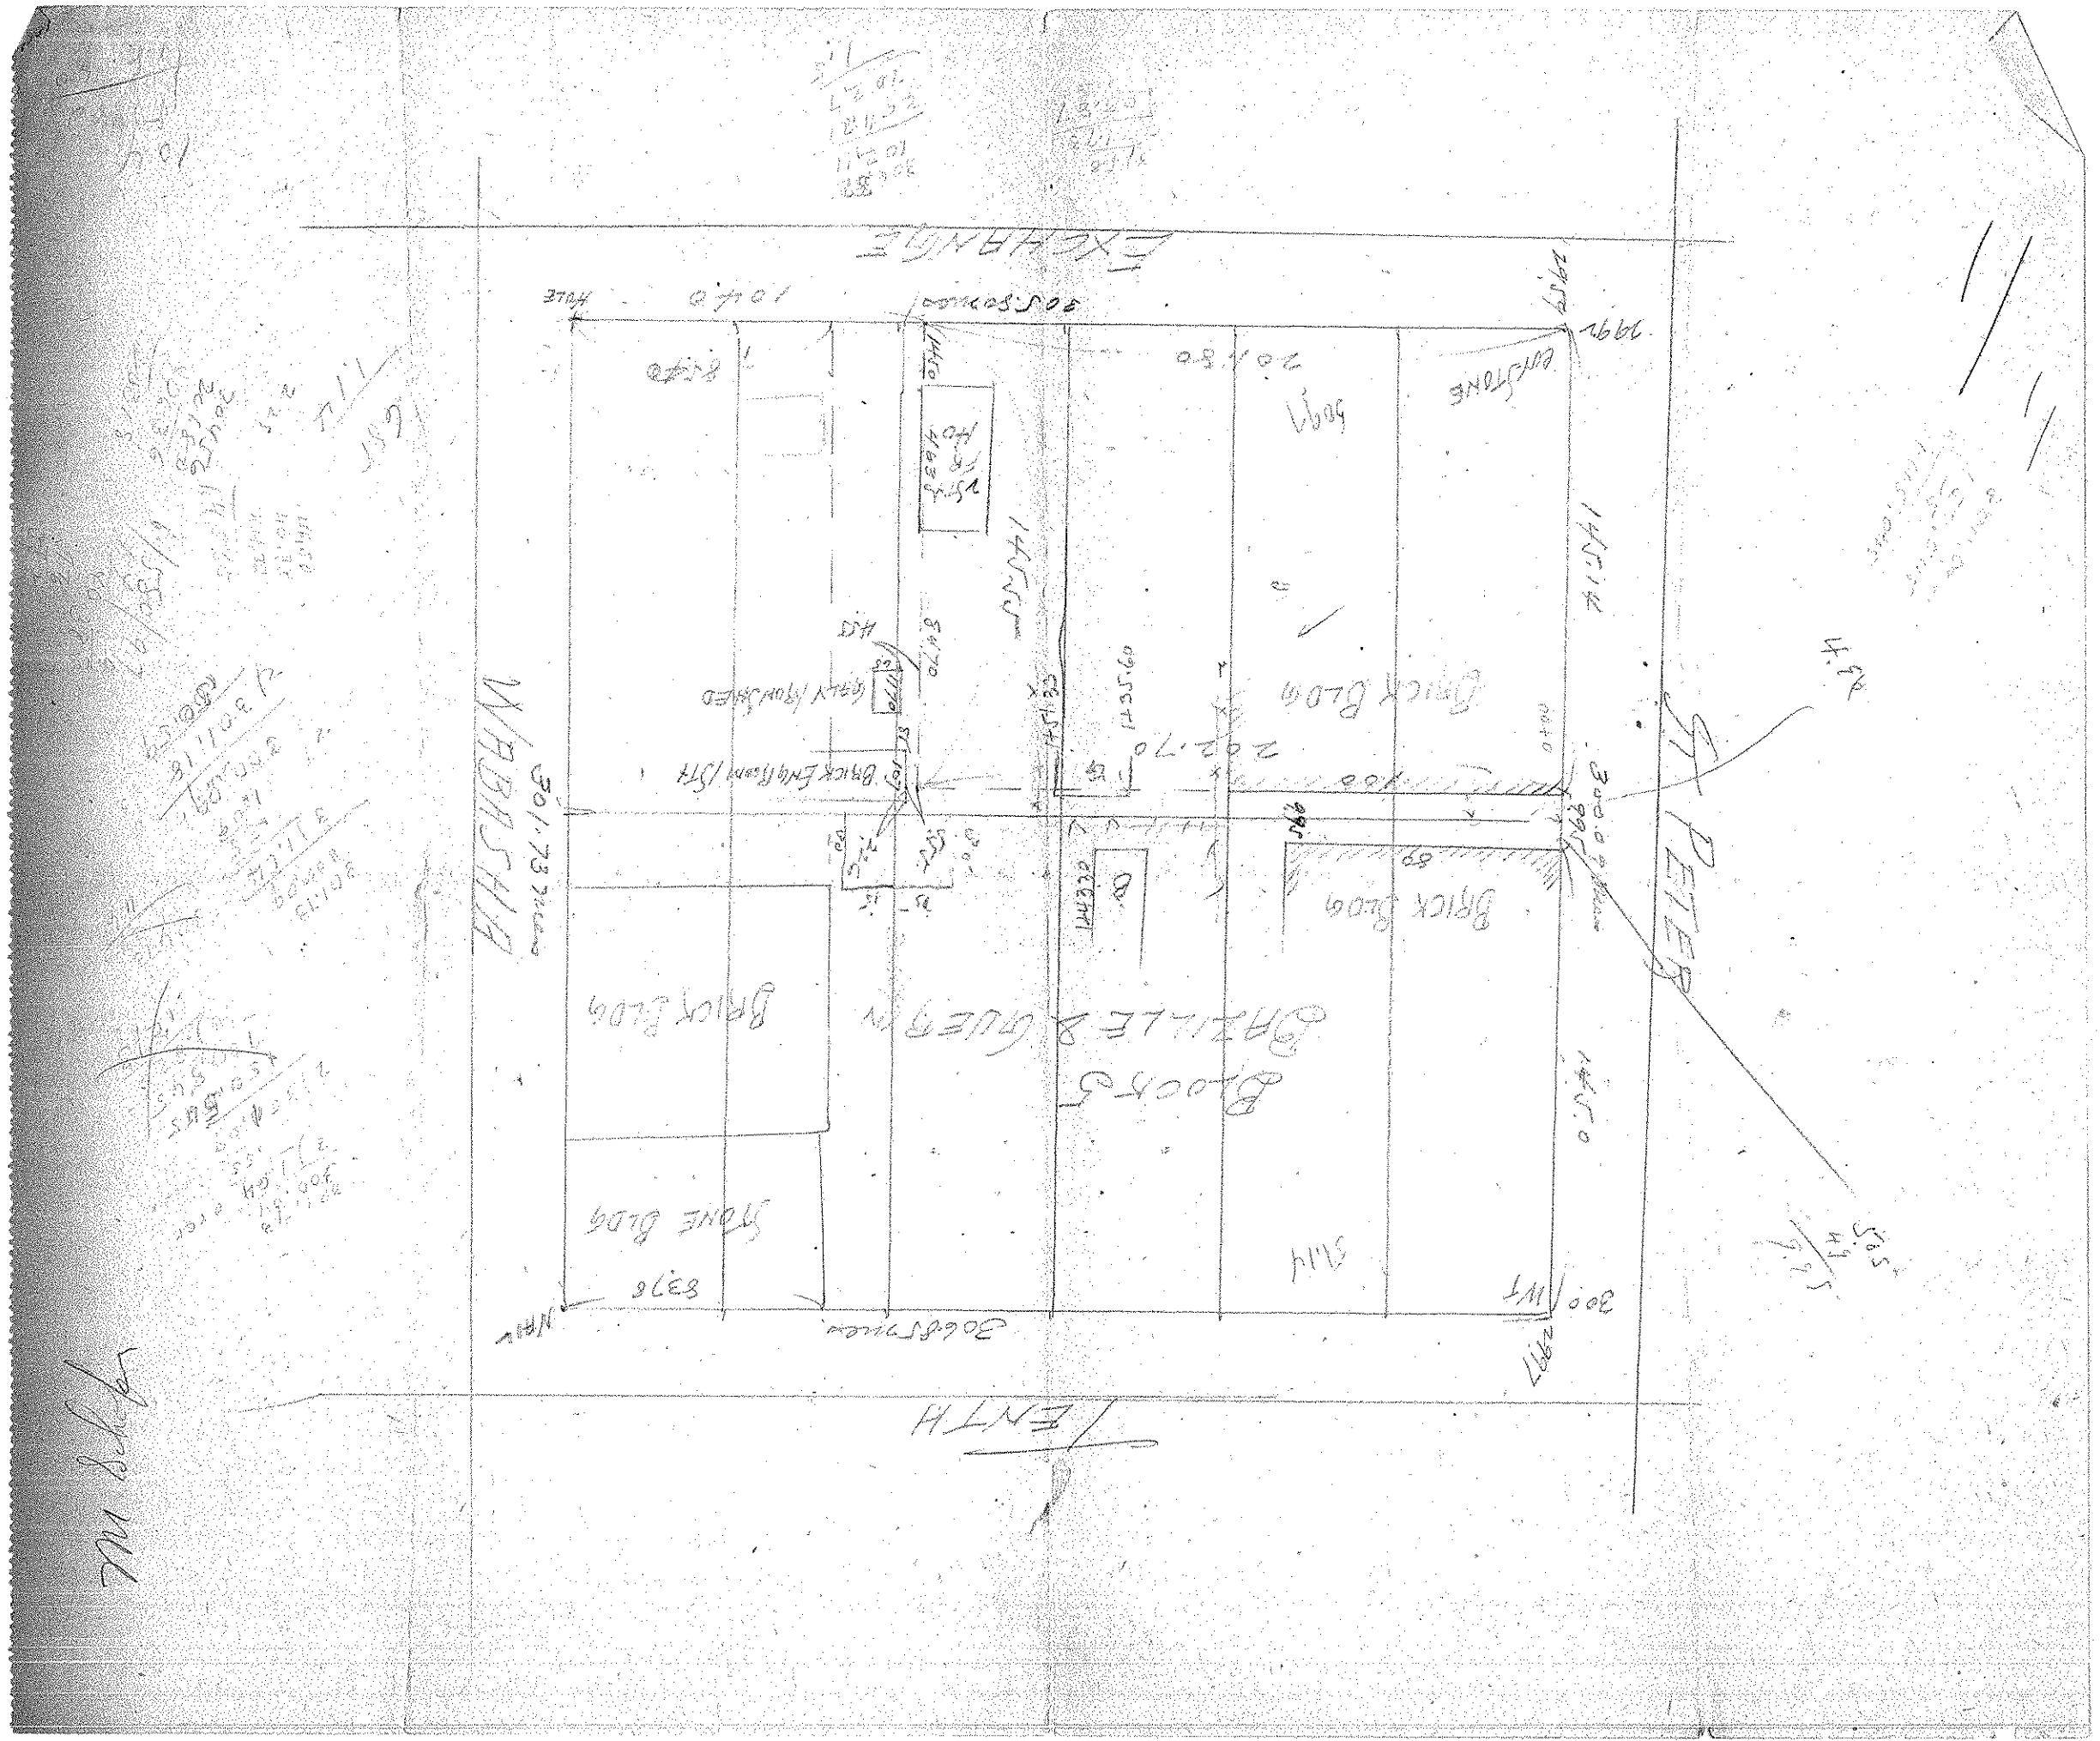
EXCHANGE
BRICK BLDG
STONE BLDG
BRICK BLDG
BRICK BLDG
BRICK