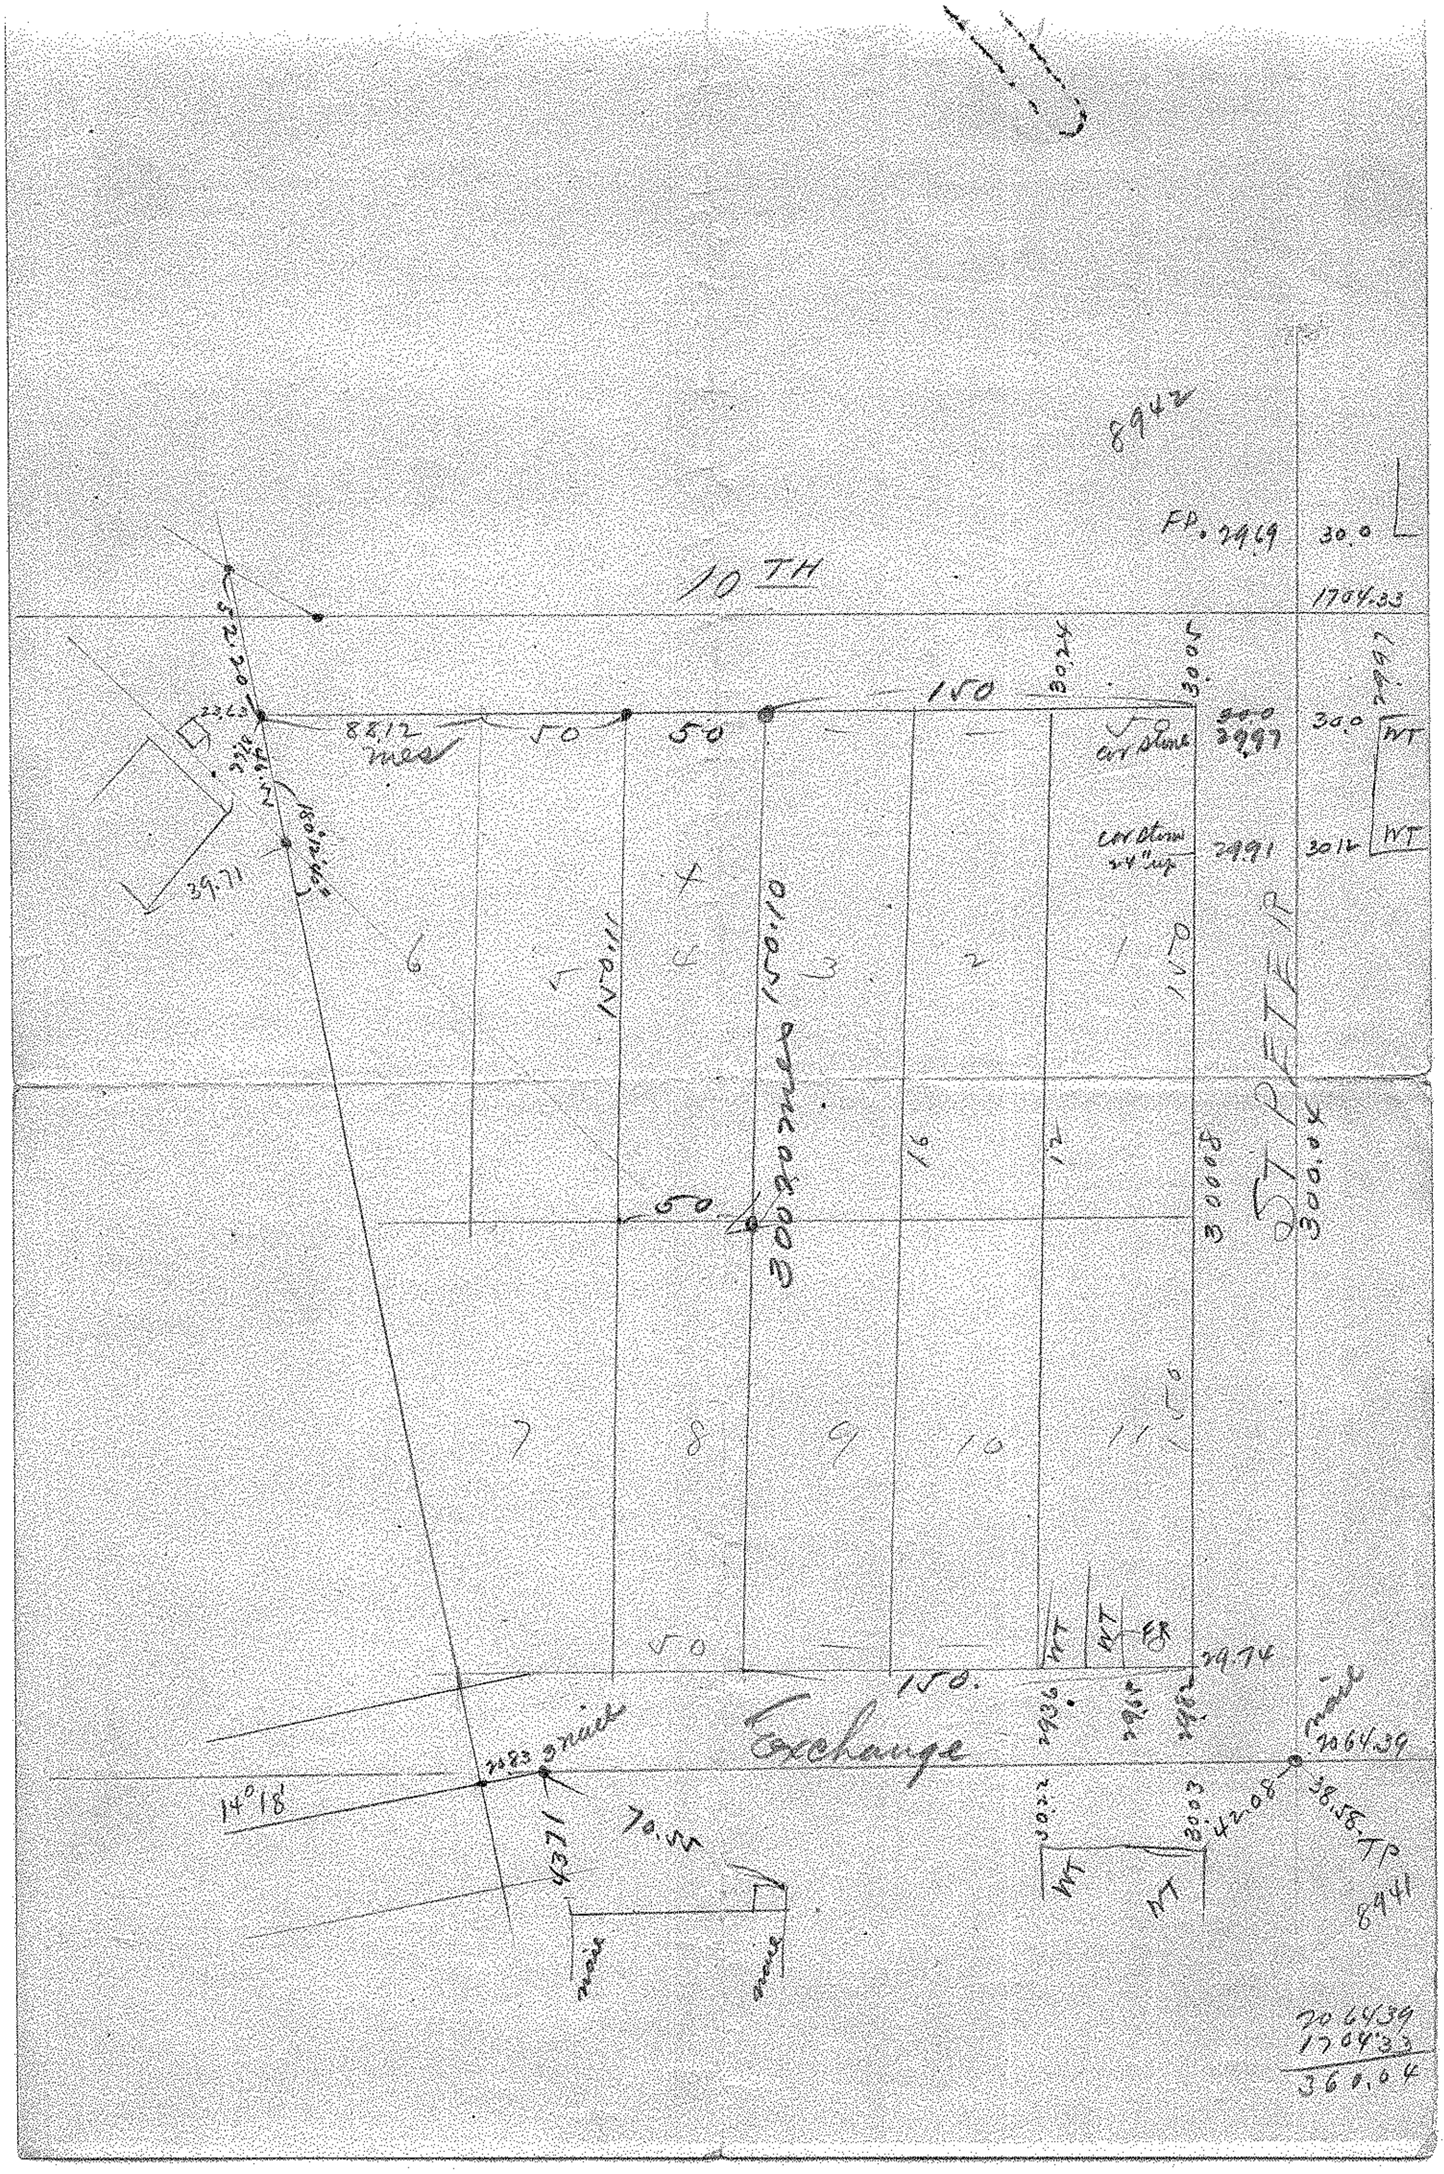
8942
FP. 29.69
30.0
1704.33
10TH
150
88.12
mes
50
50
cor stone
cor stone 24" up
29.91
30.16
WT
WT
39.71
6
5
4
3
2
1
16
12
50
7
8
9
10
11
WT
WT
29.74
150.
Exchange
ST PETER
300.0
14°18'
70.55
nail
nail
nail
2064.39
42.08
38.58 TP
8941
2064.39
1704.33
360.04