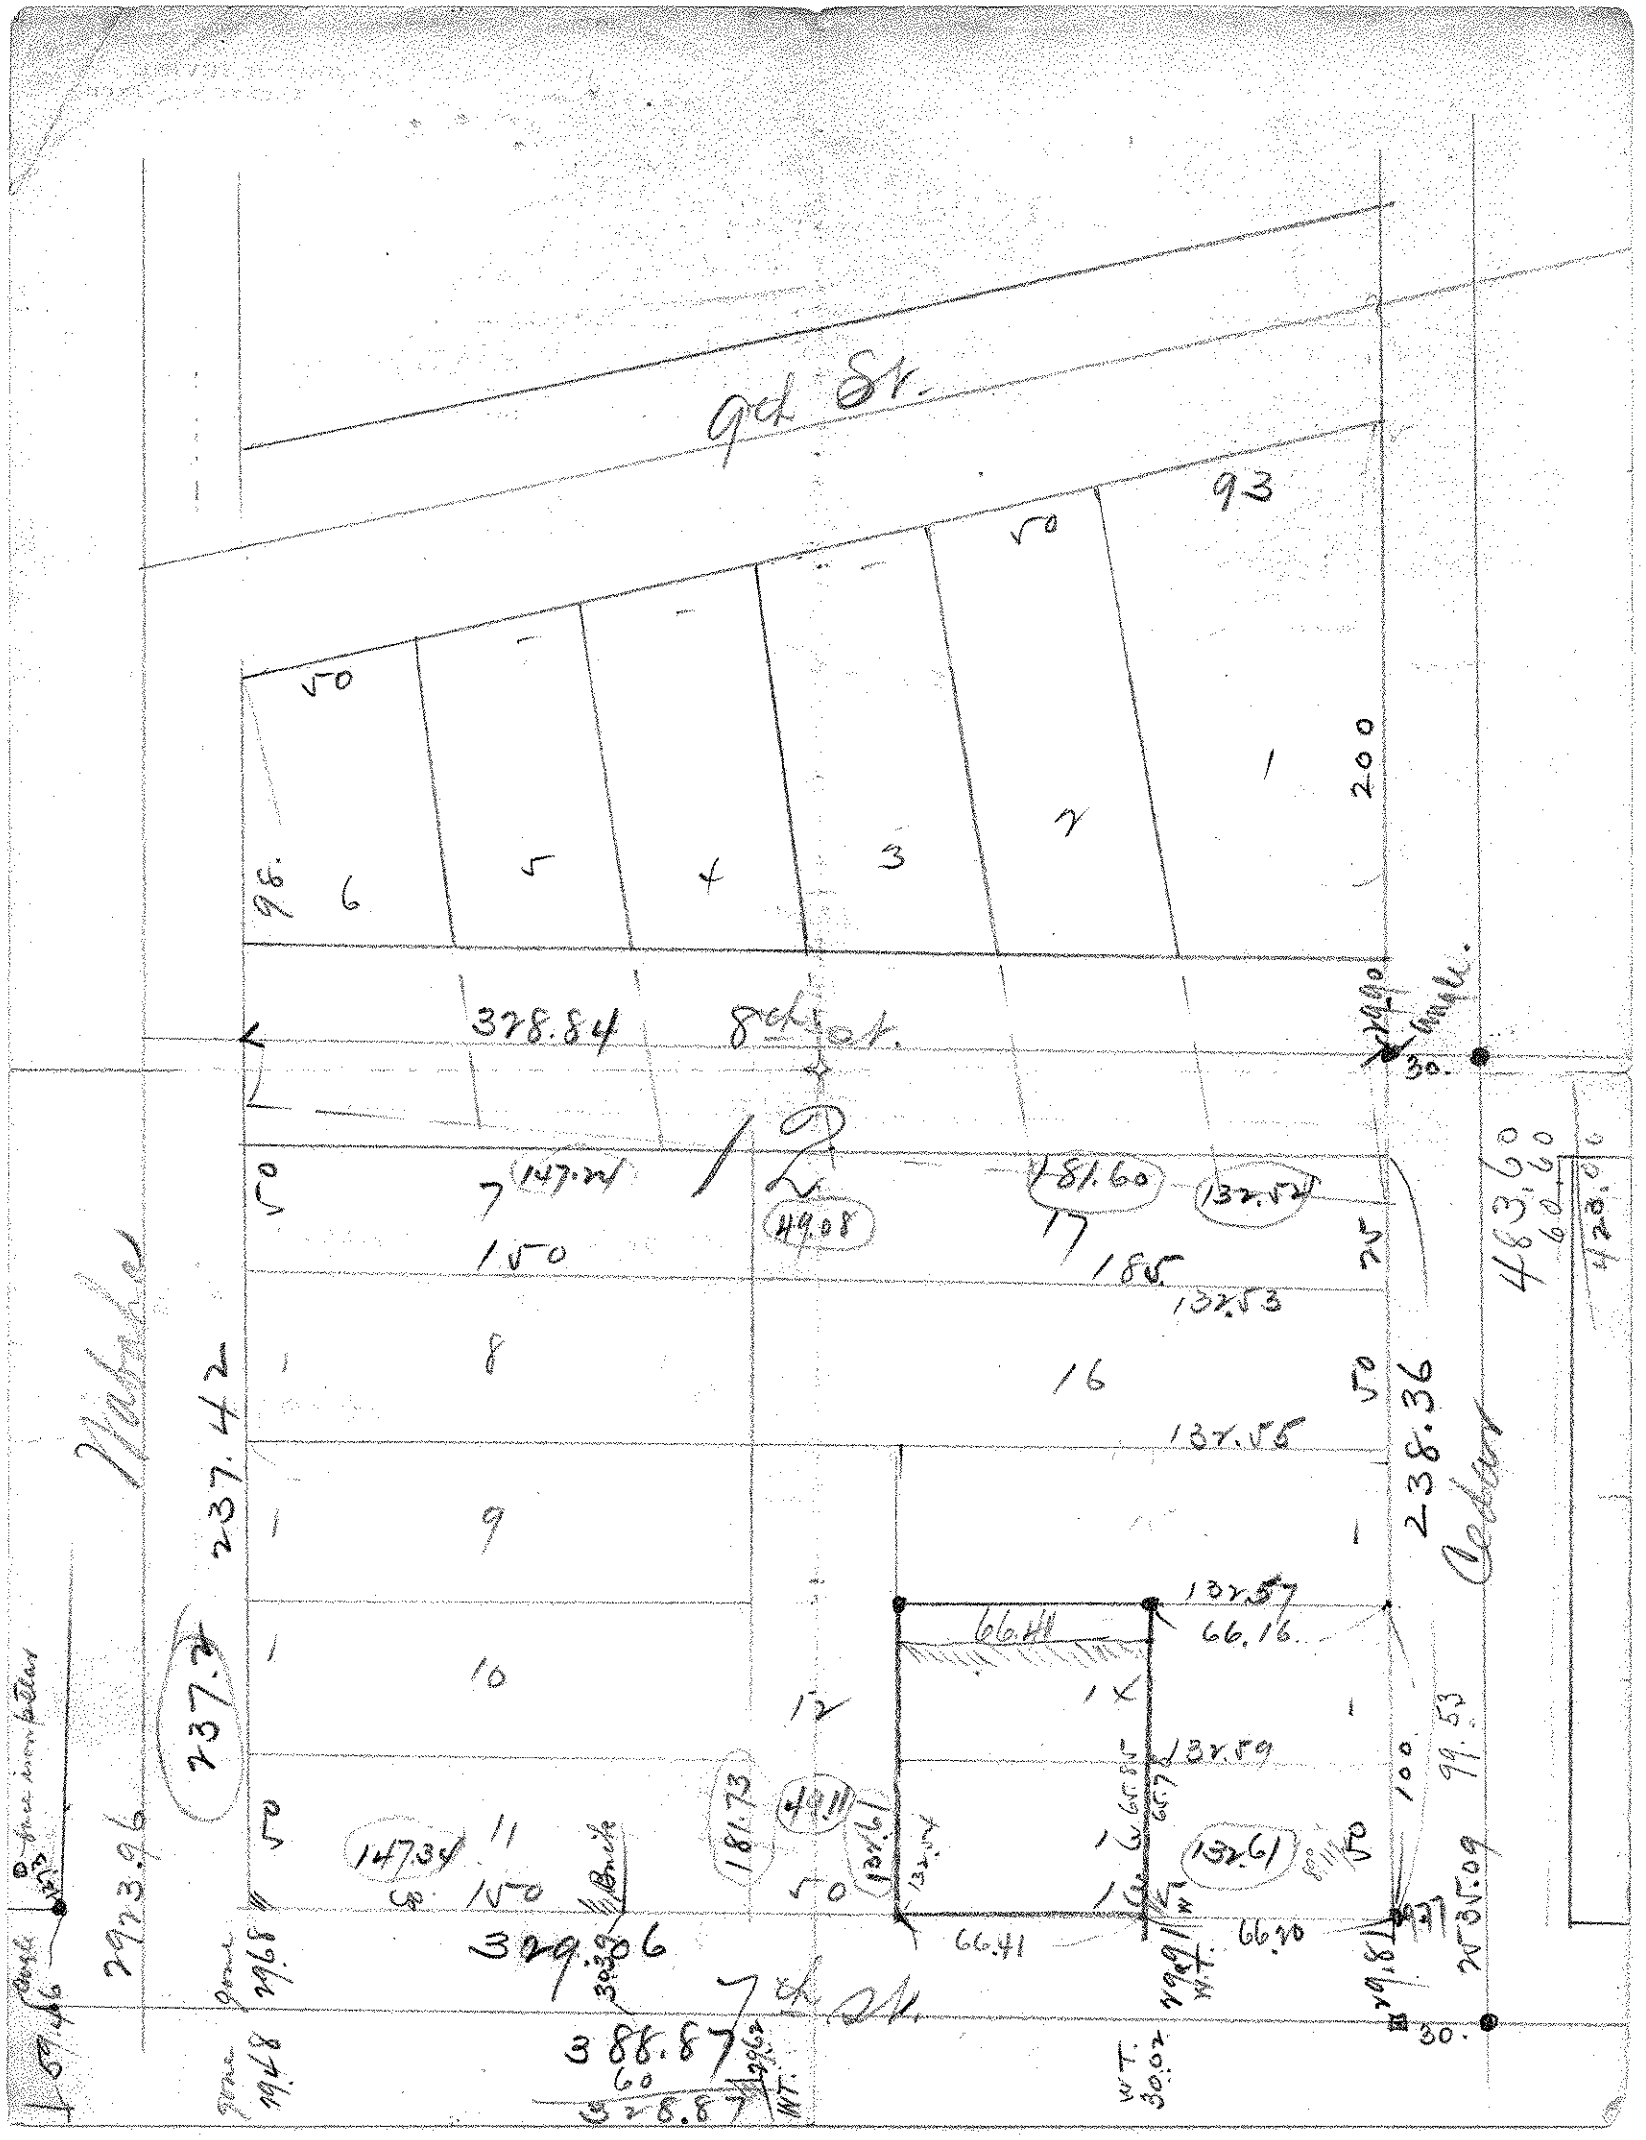
9th St.
93
50
200
1
2
3
4
5
6
98
328.84
8th St.
12
7
147.24
49.08
181.60
132.52
17
185
132.53
8
16
132.55
9
10
11
132.57
66.16
66.41
132.59
132.61
66.20
12
14
181.73
49.11
147.34
150
329.06
388.87
60
328.87
7th St.
Nabahas
237.42
237.2
2923.96
238.36
Cedar
483.60
60.60
423.00
100
99.53
2535.09
30.
W.T.
30.02