

Snell Sash & Door Company.
Bowling Add.

T. J. Welch, Reg. Surveyor.

738 Sursey Avenue


St. Paul, Minn.

Tel. To. 0640.

91 E.

DAYTON

Scale 1 inch 50 feet
O indicates iron.

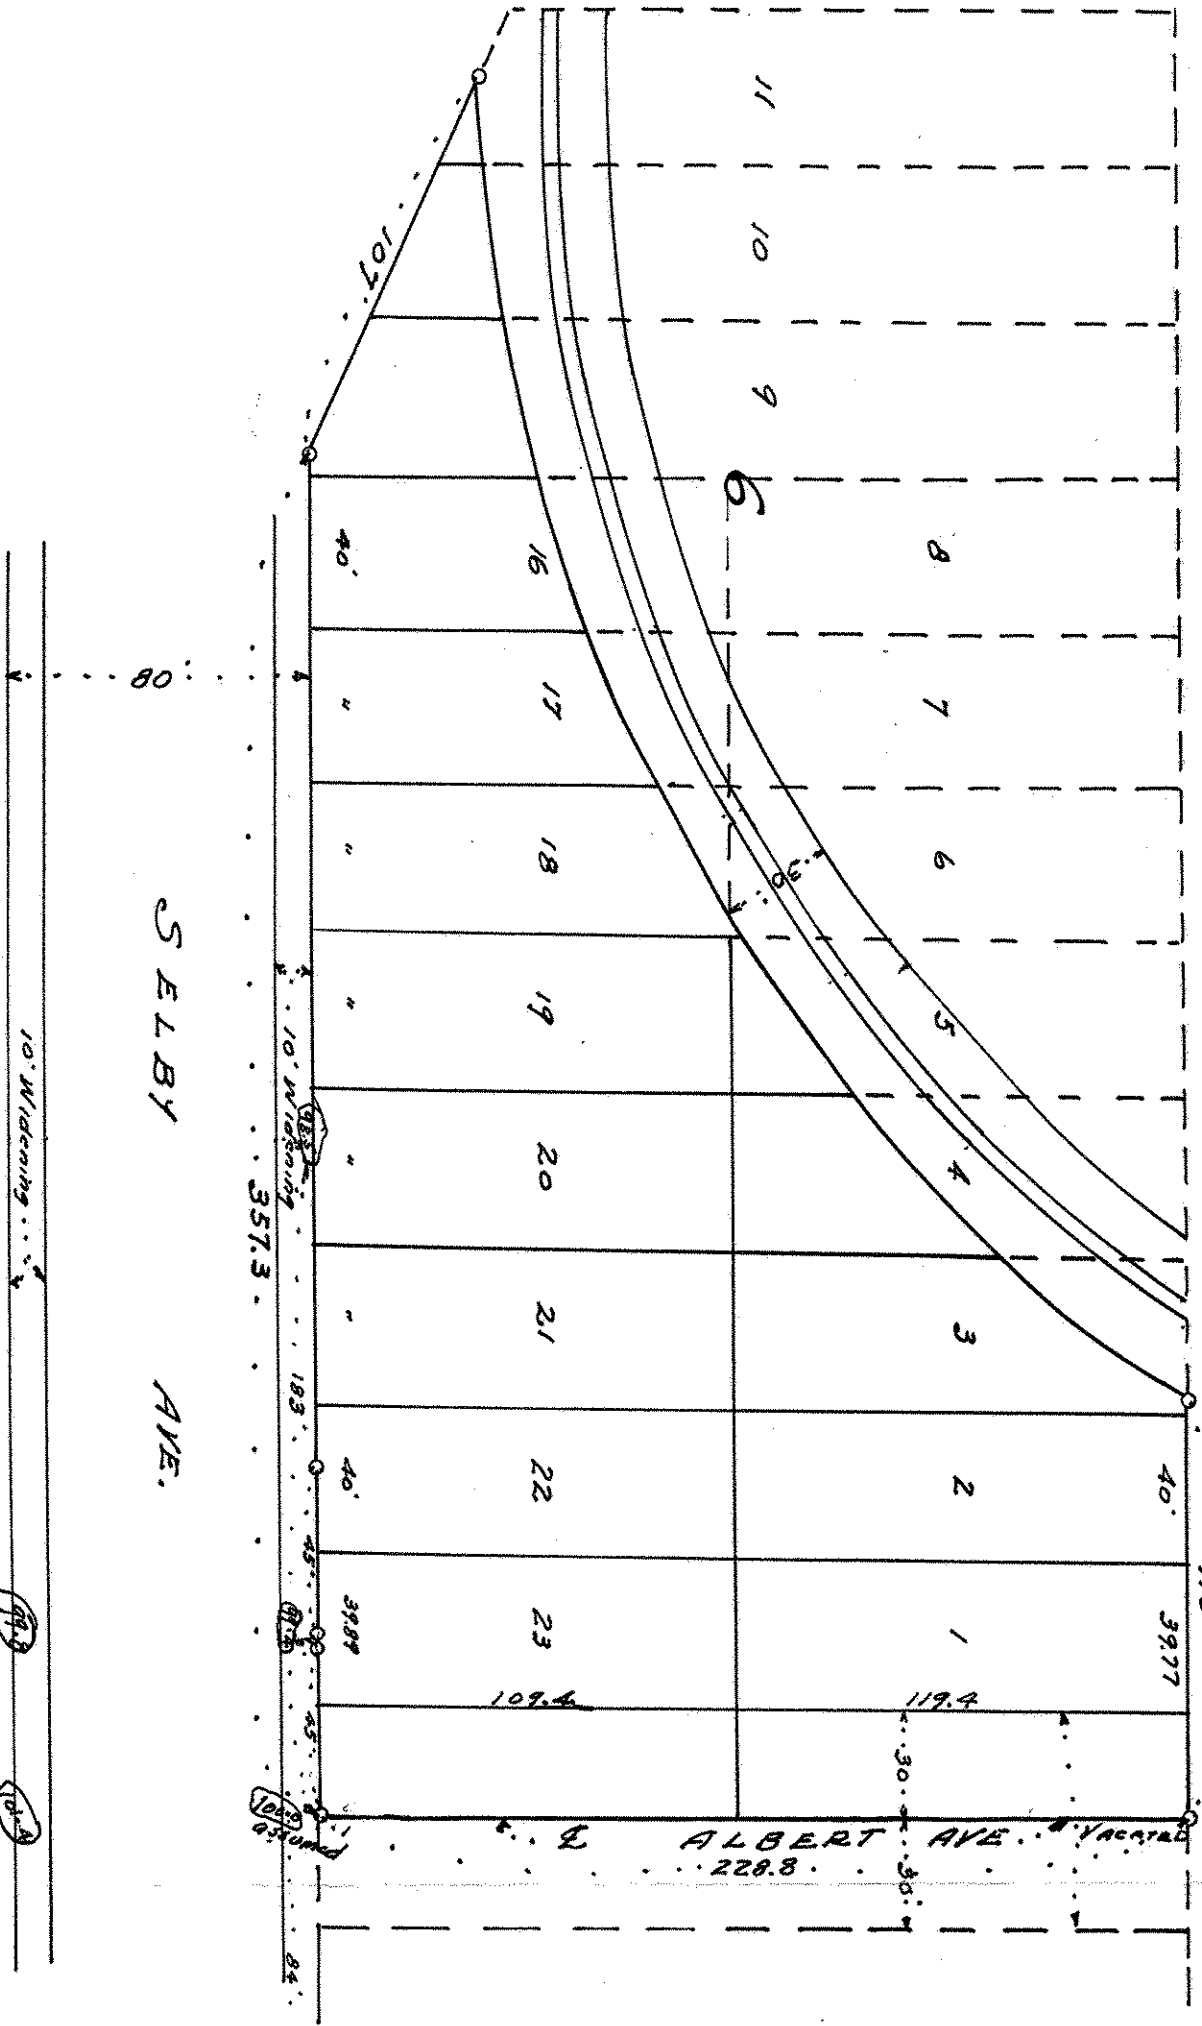

10' Widening

99-A

10-A

Swath
99-A

10-A