NW 12 28 22

Description -(To be verified)

All that part of the NE 1/4 of the NW 1/4 of Section 12, T28, R22 lying Southerly of the South line of Lower Afton Road except the East 330 feet thereof.

Also The South 333 feet of the West 230 feet of the East 330 feet of the NE 1/4 of the NW 1/4 of Section 12, T28, R22.

Ramsey County, Minn

5-25-72 Added areas and field data
Contains 22.685 acres, more or less, area includes North 33 foot of Londin Lane.

File

For: James Riley
424 West Thompson Ave.
West St Paul, Minn

SCALE 1" = 200'
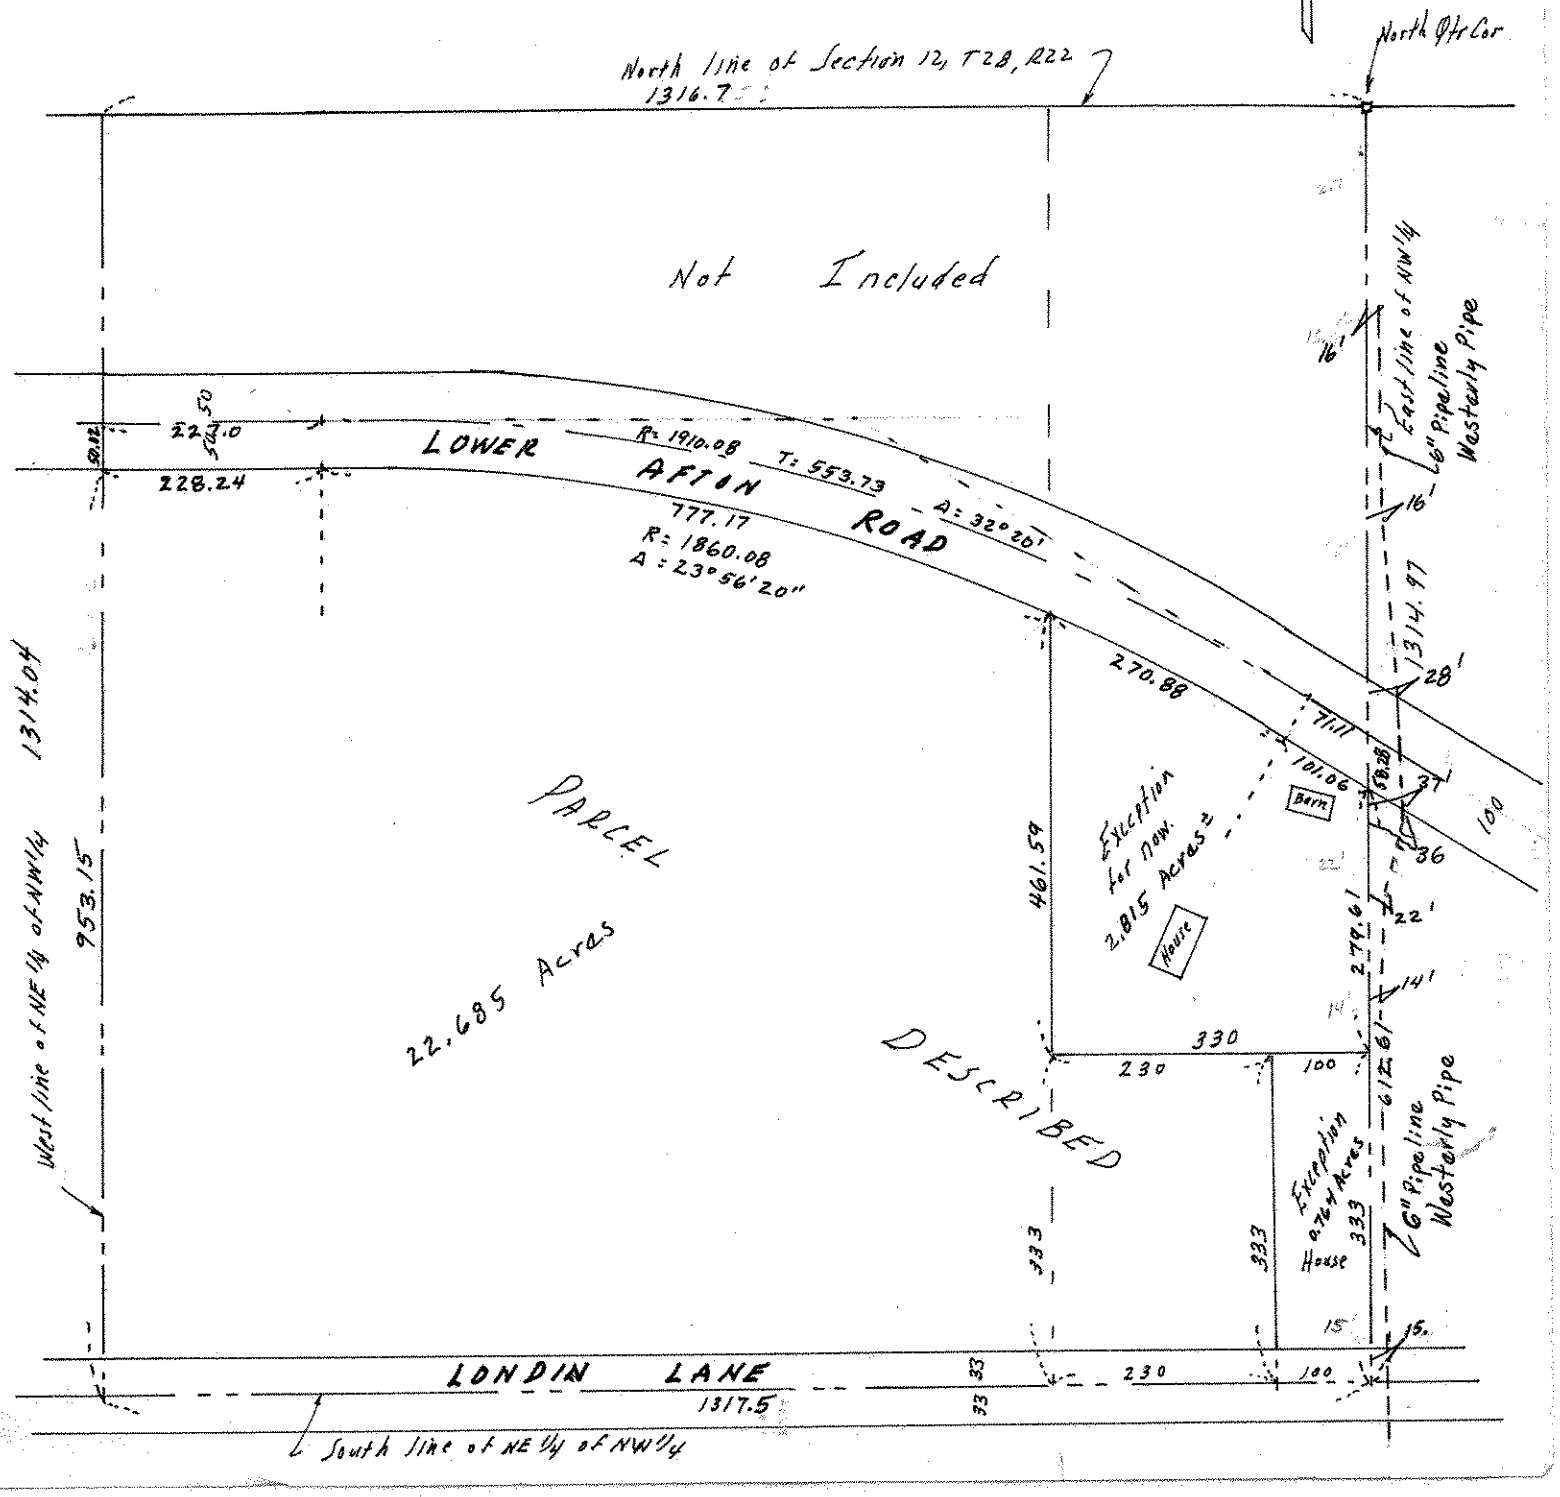
Dwg. by: C.O. Georgi