


Ra
 Raasch
 Biseng Swiss Meadows



North line of SE 1/4 of NE 1/4 of NE 14-28-22

657.36
 588 51 45 E

16000' 45" E
 656.70

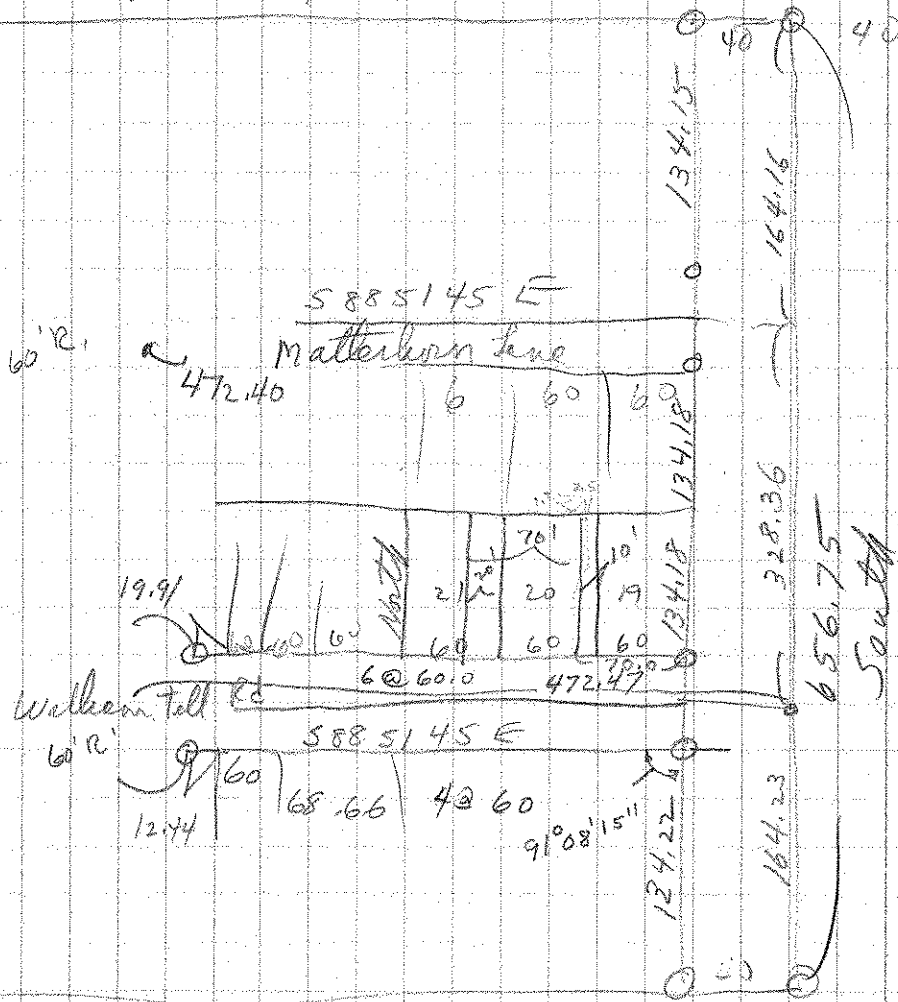

Wellken Tell Rd

60' R.

588 51 45 E

12.74

68.66 4 @ 60

91° 08' 15"

588 51 30 E

657.51

South line of SE 1/4 of NE 1/4 of NE 14

14-28-22

South
 McKnight