
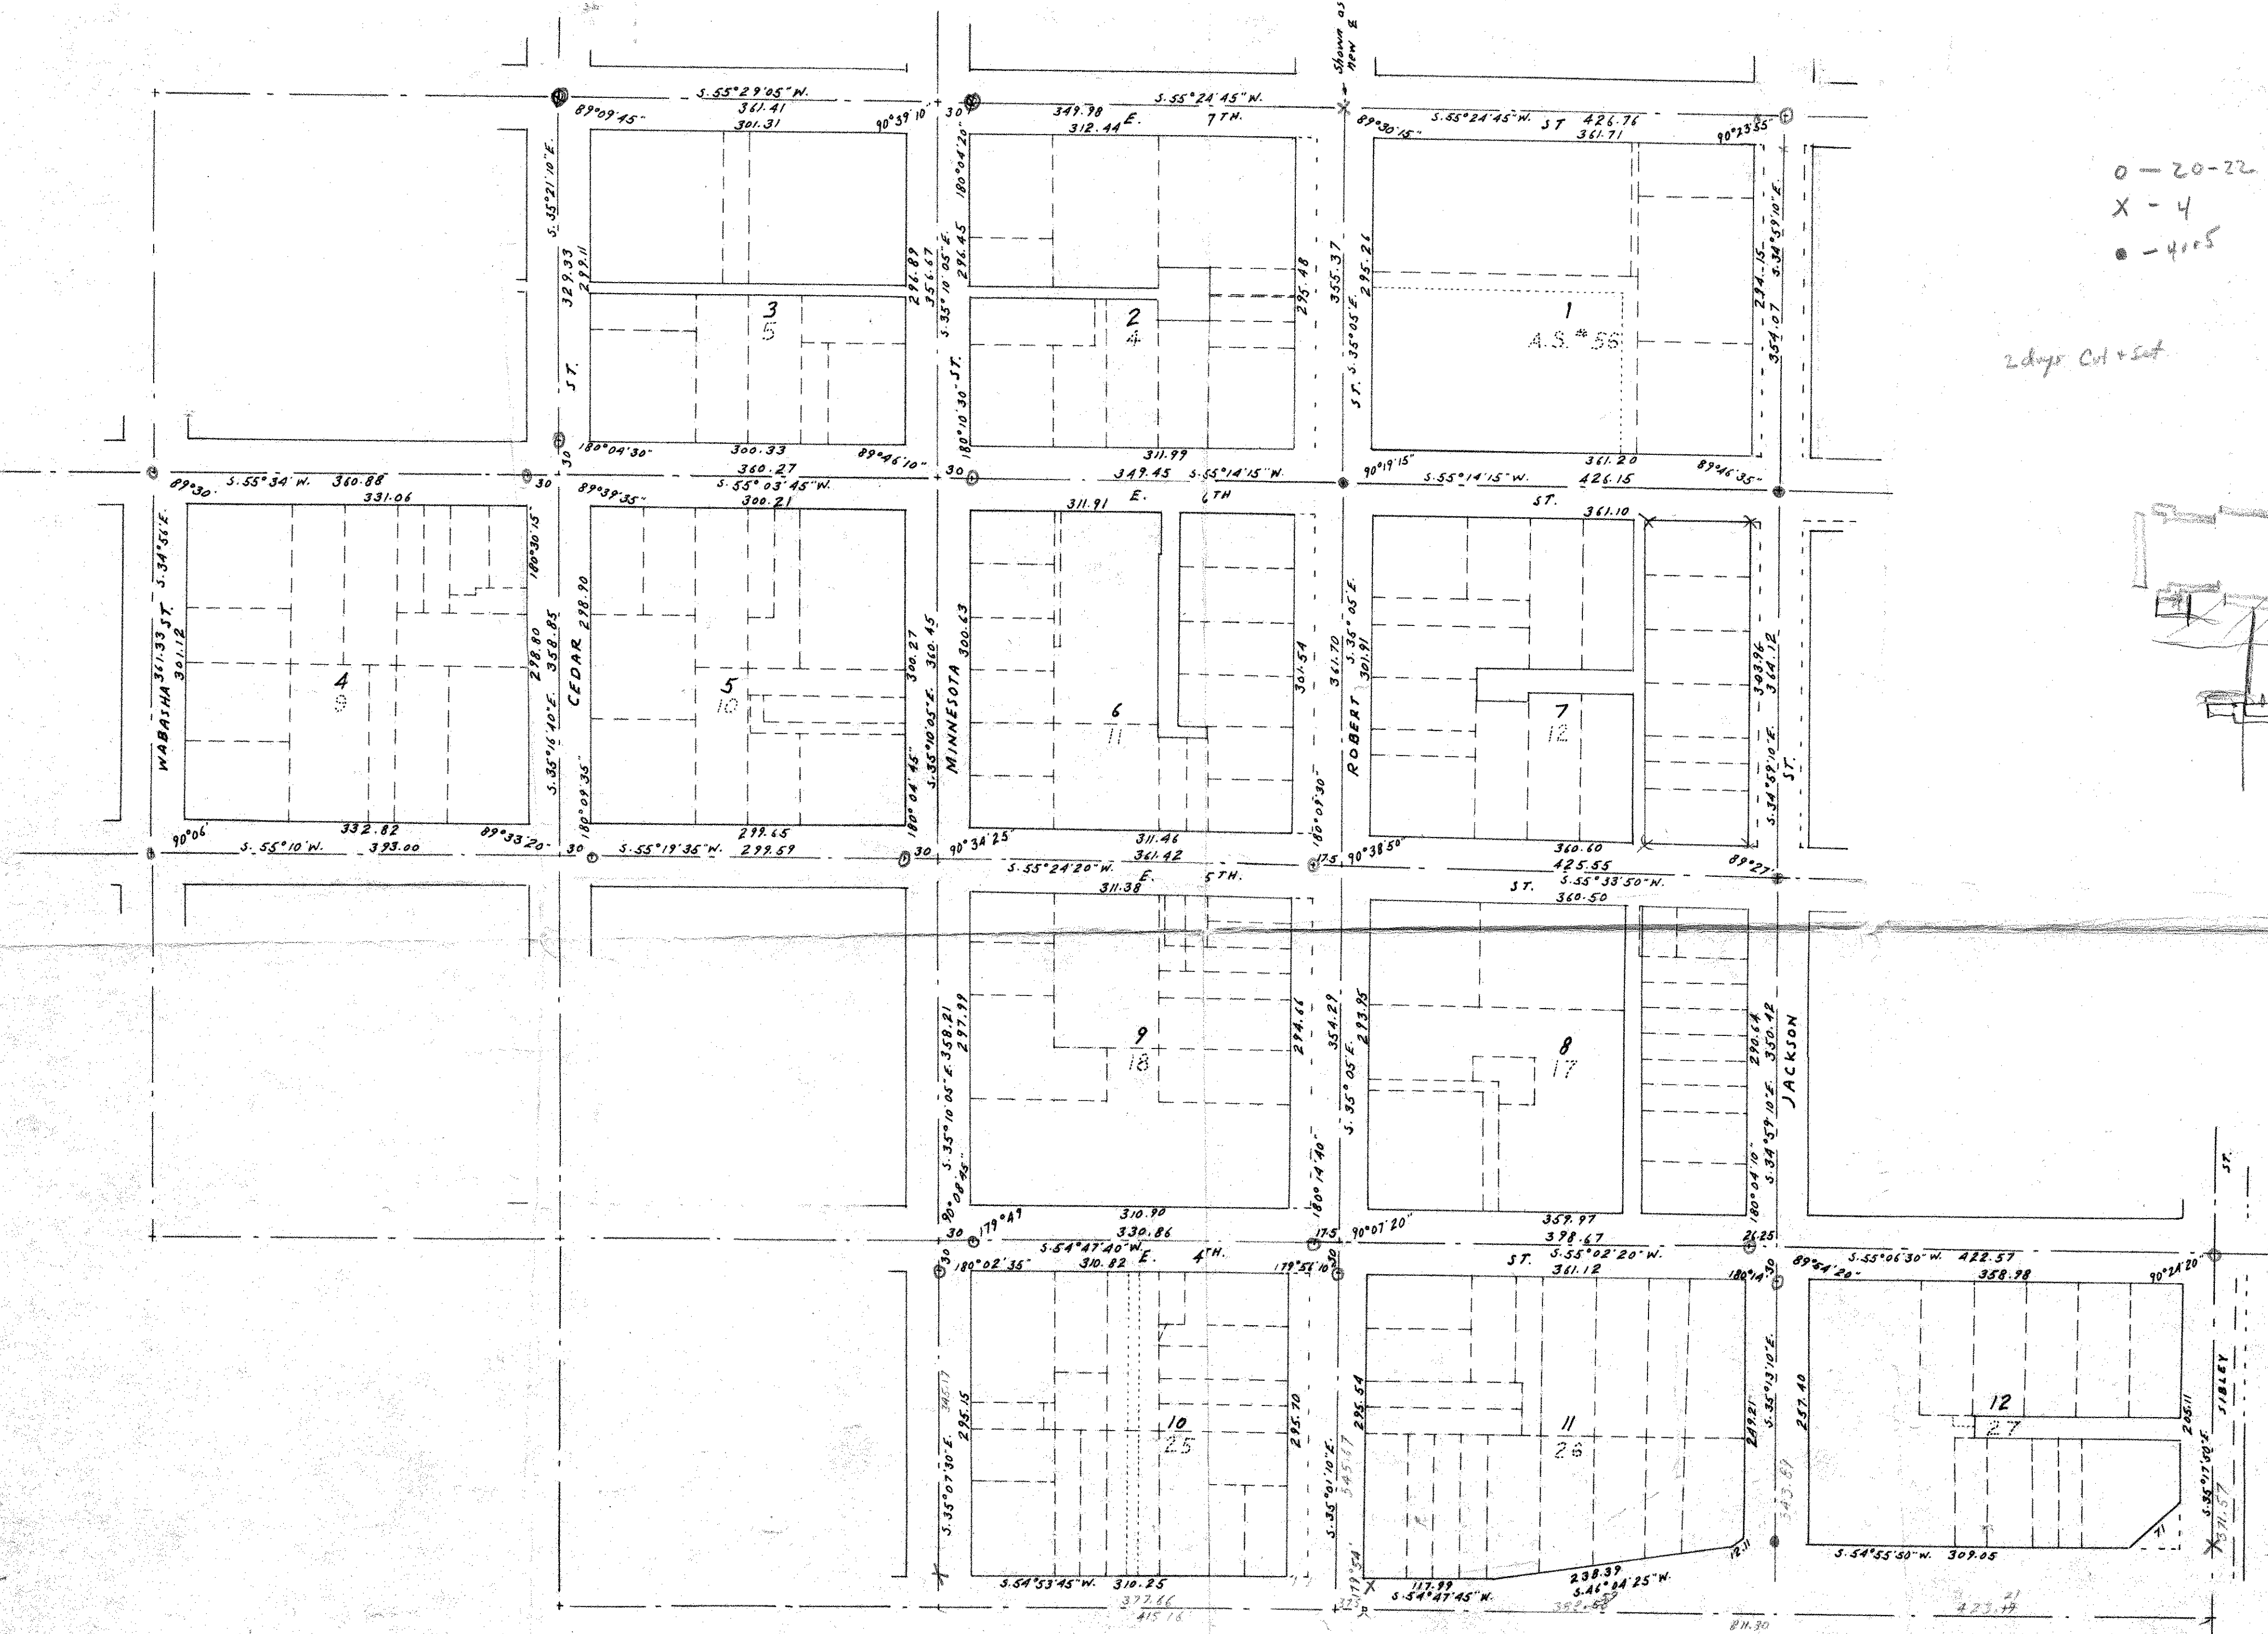


0-20-22 Casting 20
 X-4
 ●-4005
 50
 20

2 days Col + Set

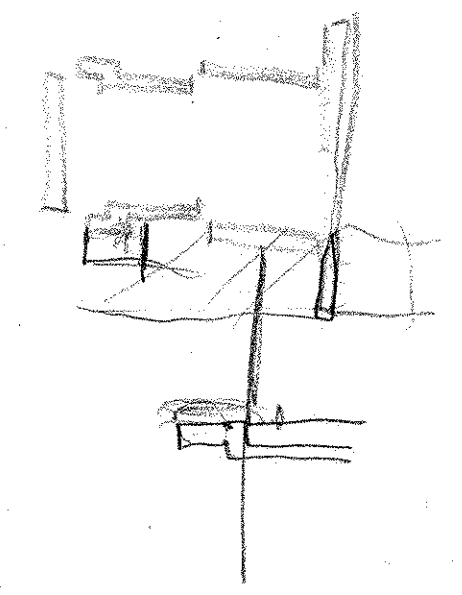

PROPERTY LINE MAP
 DOWNTOWN URBAN RENEWAL AREA
 HOUSING & REDEVELOPMENT AUTHORITY
 PROJECT: Minn R20
 SCALE 1"=100'