29 22

K-321
JACKSON ST.
ACKER TO SYCAMORE

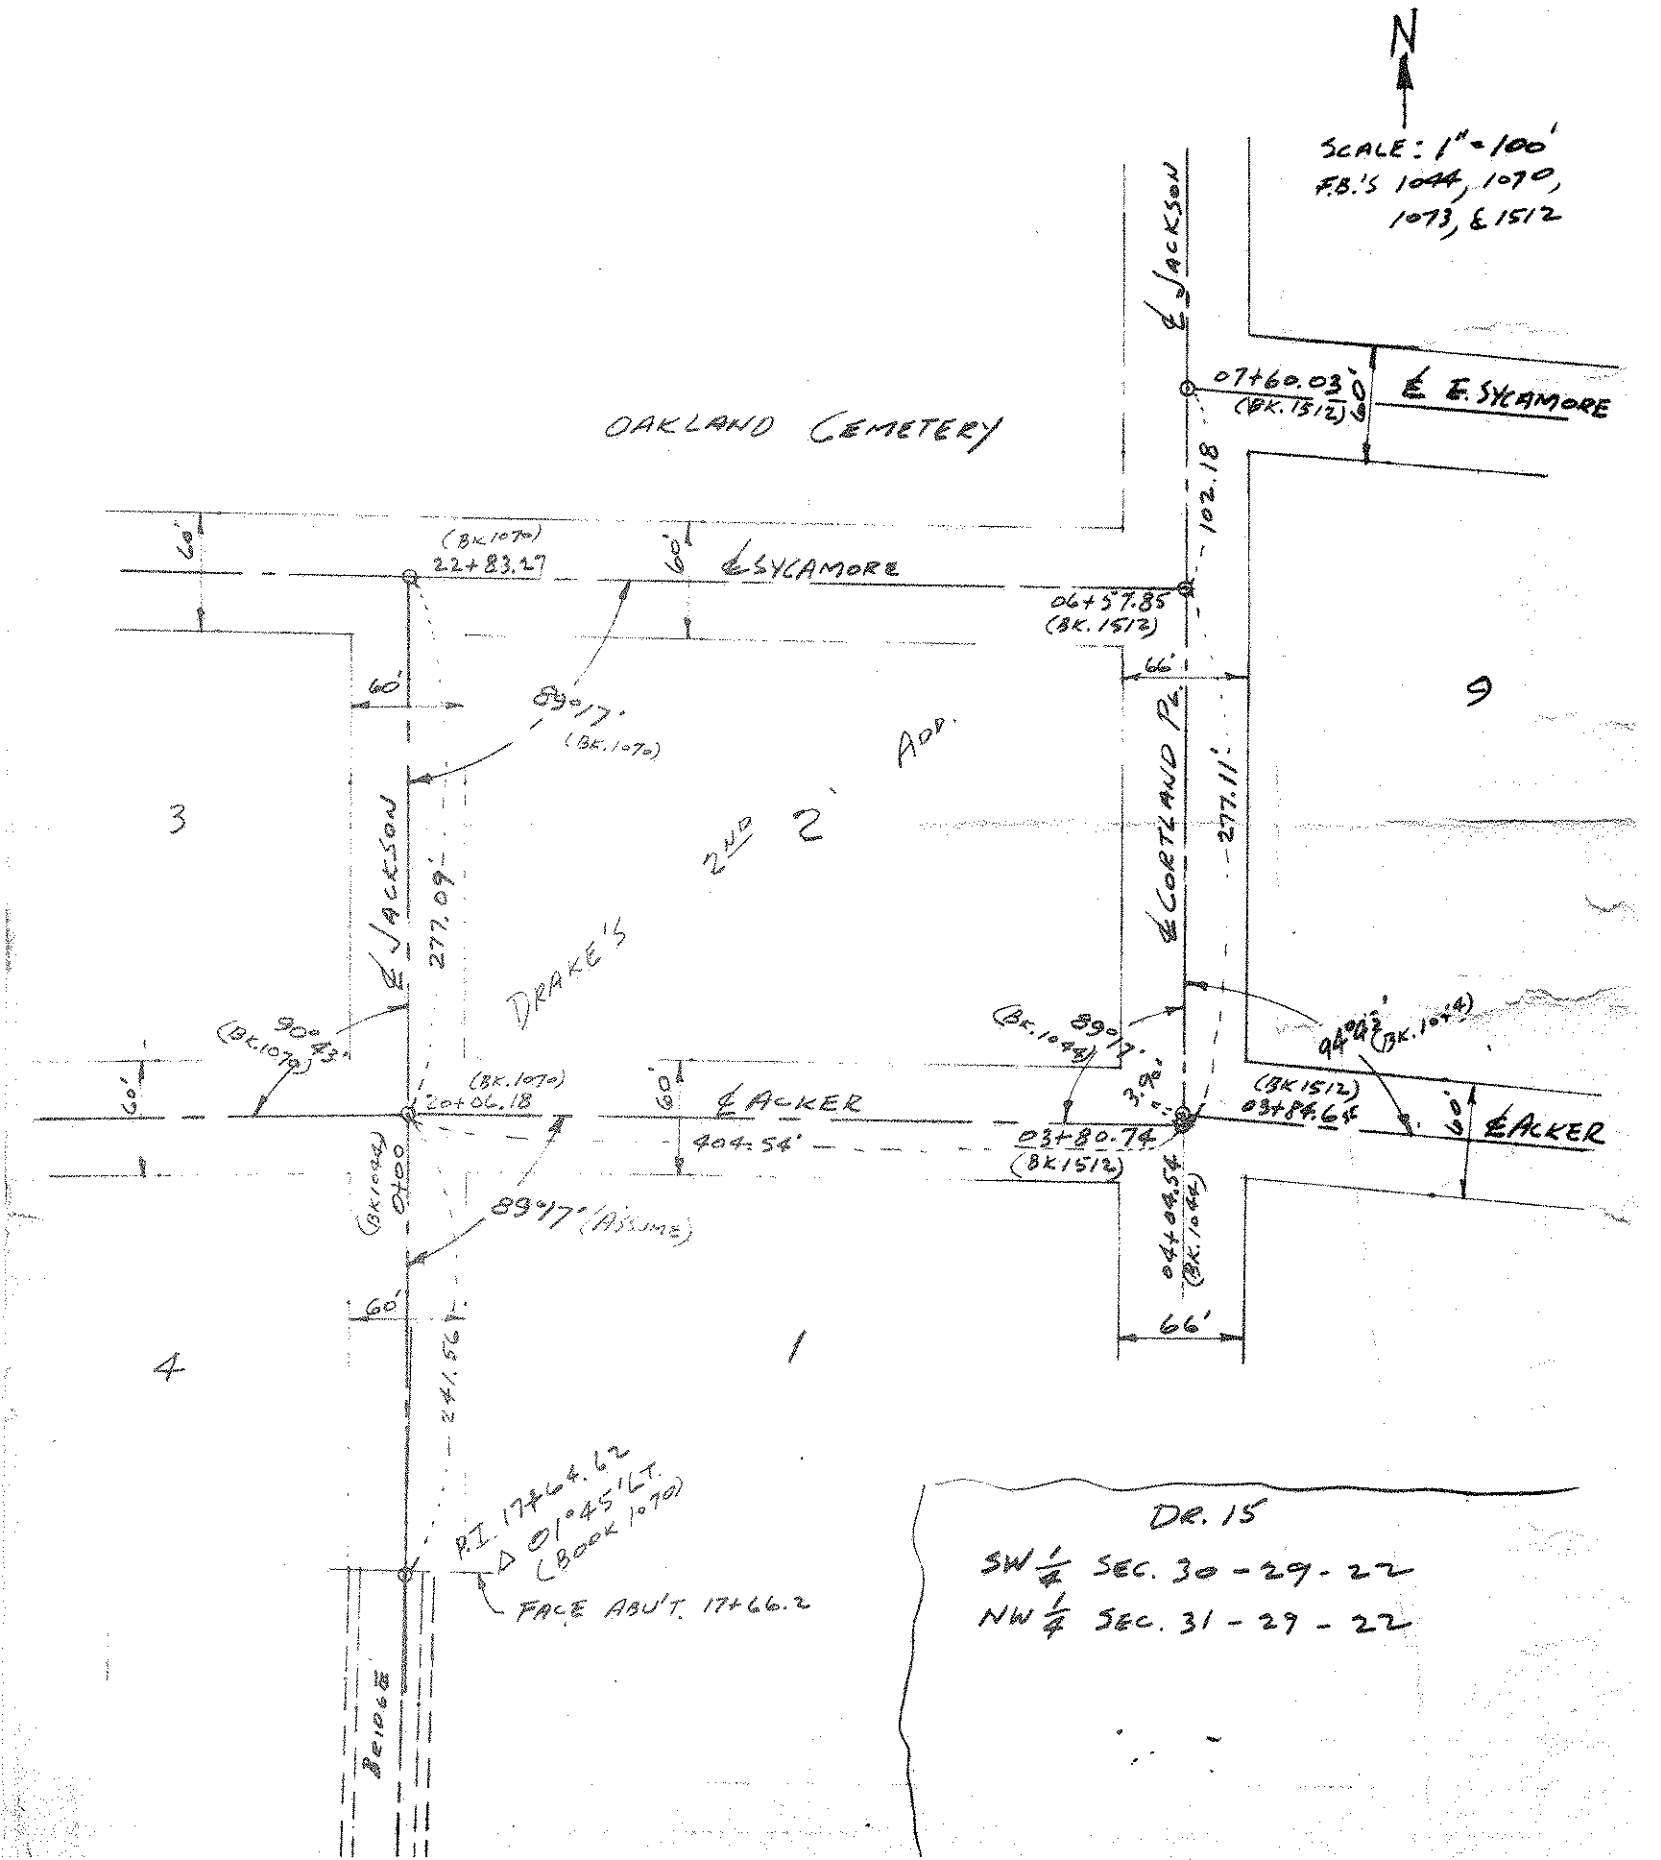

DR. 15

SW $\frac{1}{4}$ SEC. 30 - 29 - 22

NW $\frac{1}{4}$ SEC. 31 - 29 - 22