
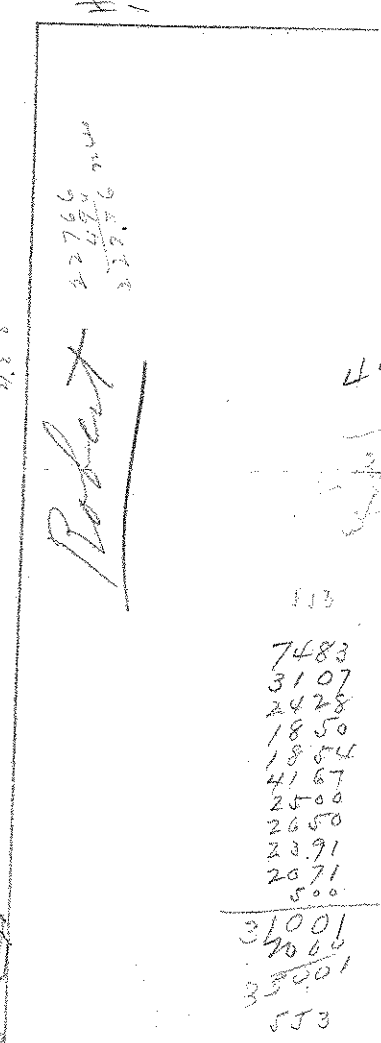


179° 55'  
11402.17  
60

3rd St

445.03

309.11  
310.03  
310.01

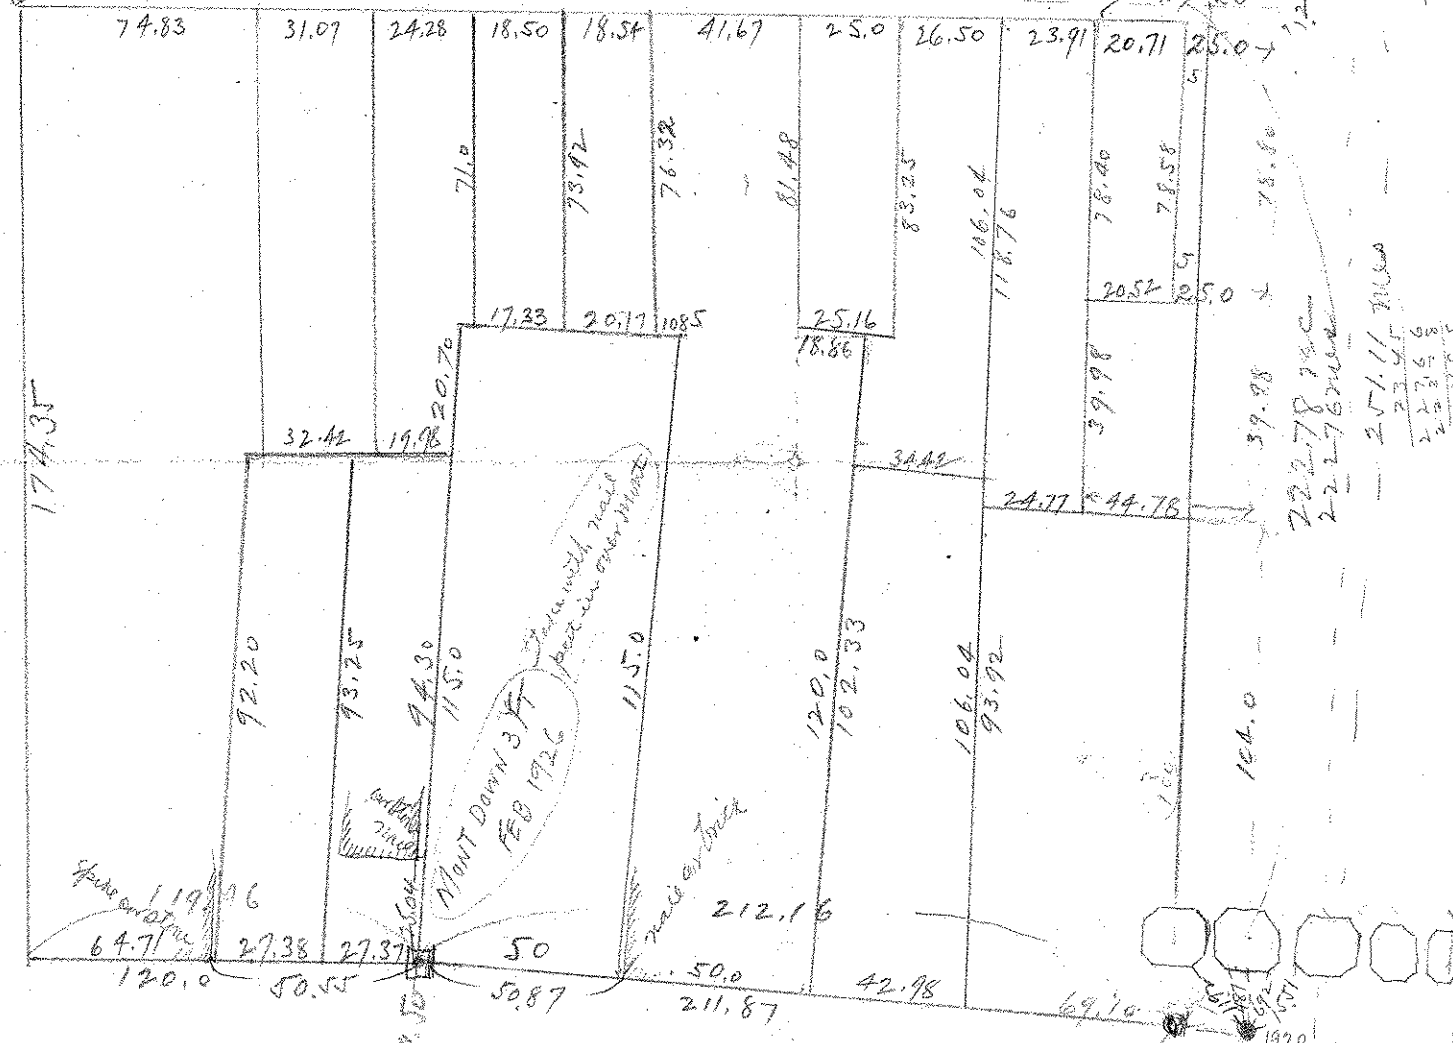


445.03  
60  
385.03  
31

113  
7483  
3107  
2428  
1850  
1854  
4167  
2500  
2650  
2391  
2071  
500  
31001  
3066  
33001  
553

14295  
6919  
2213

14298  
6919  
21216

2nd St

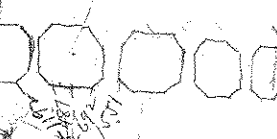

114057  
1920