


2521 S. Shore Blvd.



6440 Flying Cloud Drive
Eden Prairie, Minnesota 55344
(952) 941-3031

June 9 2009

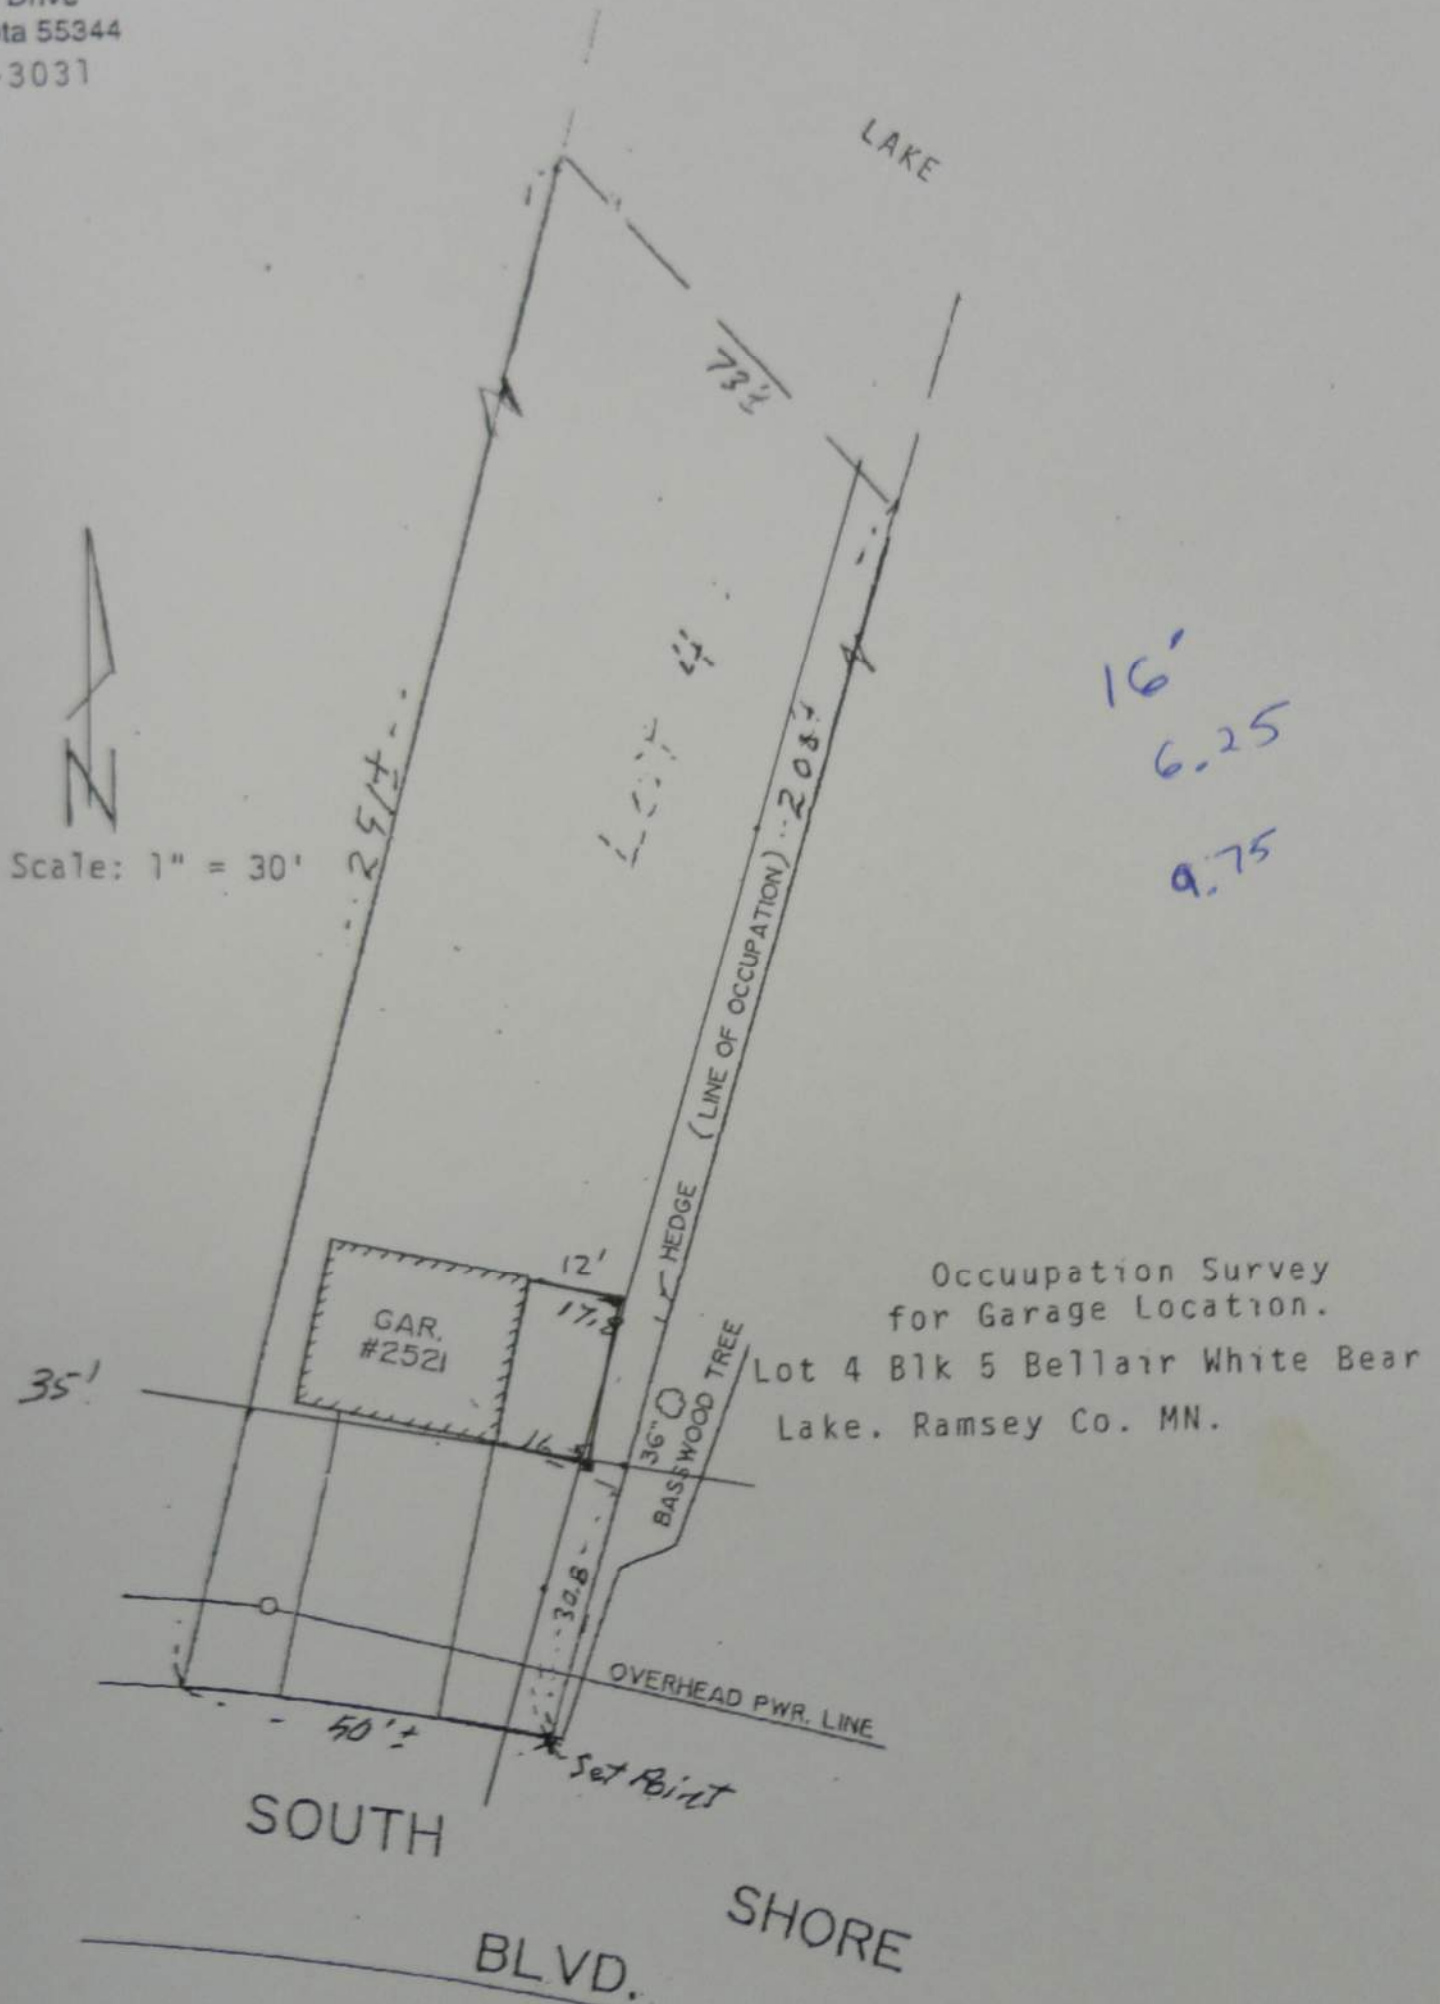

Occupation Survey
for Garage Location.
Lot 4 Blk 5 Bellair White Bear
Lake, Ramsey Co. MN.