

TELEPHONE: PR 6-0640

PLAT OF SURVEY


OF PROPERTY OF _____

DESCRIBED AS FOLLOWS Lots 1-2-3-4 except the North 94' thereof and Lots 27-28-29-30 except the South 90' thereof all in Block 24, Sabin Addition, together with all of the vacated alley which accrued thereto.

SCALE: 1 INCH = 50 FEET

T. J. WELCH, REGISTERED SURVEYOR
738 SURREY AVENUE, ST. PAUL 6, MINN.

BURKE AVE.

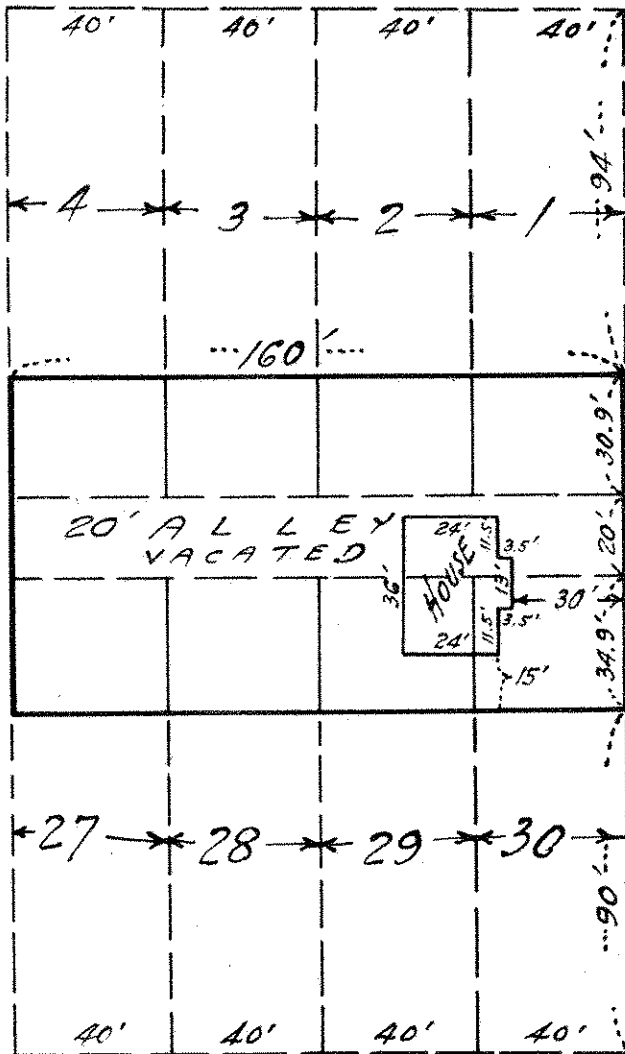

HAZELWOOD AVE.

NORTH

ELDRIDGE AVE.

CERTIFICATE OF SURVEY

I hereby certify that on January 20, 1965
I surveyed the property described above and that the
above plat is a correct representation of said survey.

T. J. Welch