SW 10 29 22

Certificate of Survey

FROM THE OFFICE OF

CHARLES O. GEORGI COMPANY

2215 West County Road B — Saint Paul, Minnesota 55113

REGISTERED CIVIL ENGINEER AND LAND SURVEYOR

I Hereby Certify that **this plat shows a survey made by me of the property described on this plat, and that the corners are correctly placed as shown, and that all locations have been correctly shown.**

Surveyed For Doug Synstegard

Date June 1976

Scale 1" = 40

By Charles O. Georgi
REGISTERED LAND SURVEYOR

Description:

Lots 3 and 4, Block 7, Sabin's Addition to Gladstone, and the North 1/2 of adjoining vacated alley.

Ramsey County, Minnesota

N

o Denotes Iron Monument
* See note

Surveyor's Note:
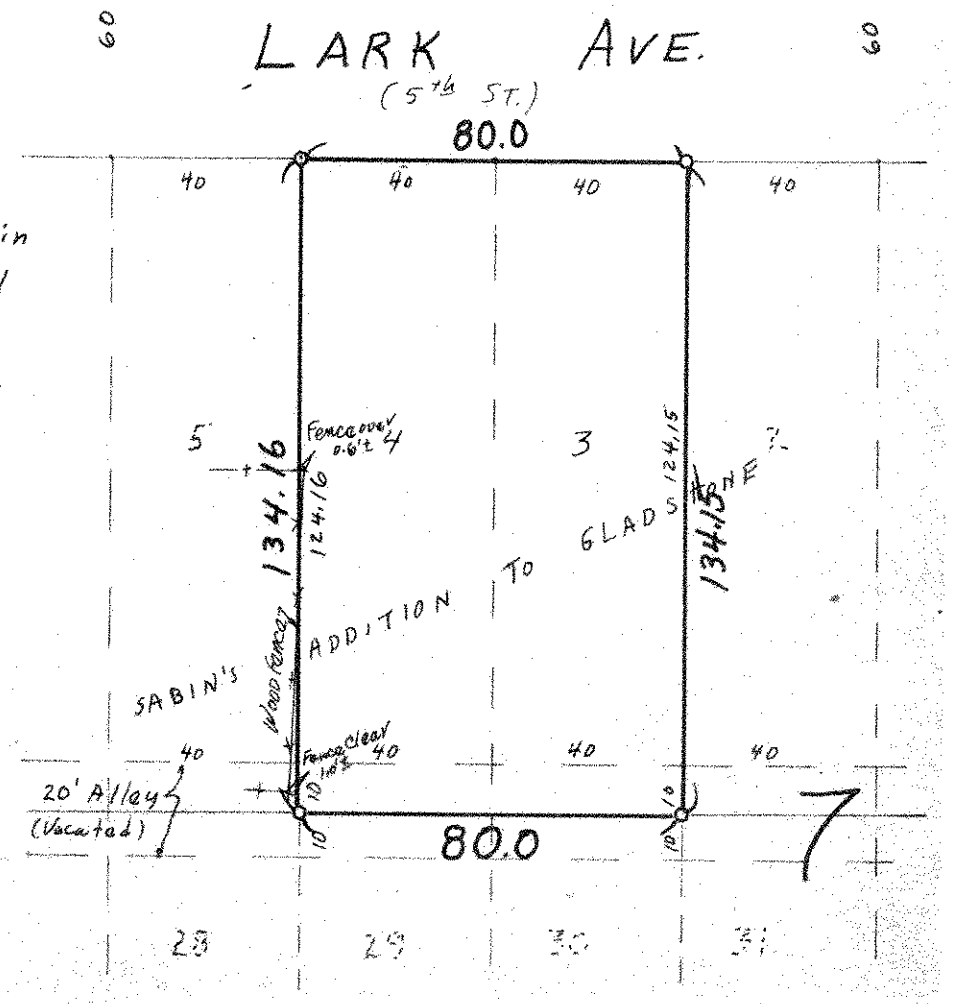
The plat of Sabin's Addition within the Quarter Section was measured and prorated therein, and is in agreement with most irons inplace.