

CHARLES O. GEORGI COMPANY

2215 West County Road B

Saint Paul 13, Minnesota

REGISTERED CIVIL ENGINEER AND LAND SURVEYOR

Certificate of Survey

I Hereby Certify that this plat shows a survey made by me of the property described on this plat, and that the corners are correctly placed as shown, and that all locations have been correctly shown.


Surveyed For Fred Weston

Date MAY 1963

Scale 1" = 50'

By Charles O. Georgi
REGISTERED LAND SURVEYOR

Description: All of Lot 16 and Lot 17 except the East 5 feet Block B, Sabin's Addition to Gladstone Add. together with the S 1/2 of vacated alley.

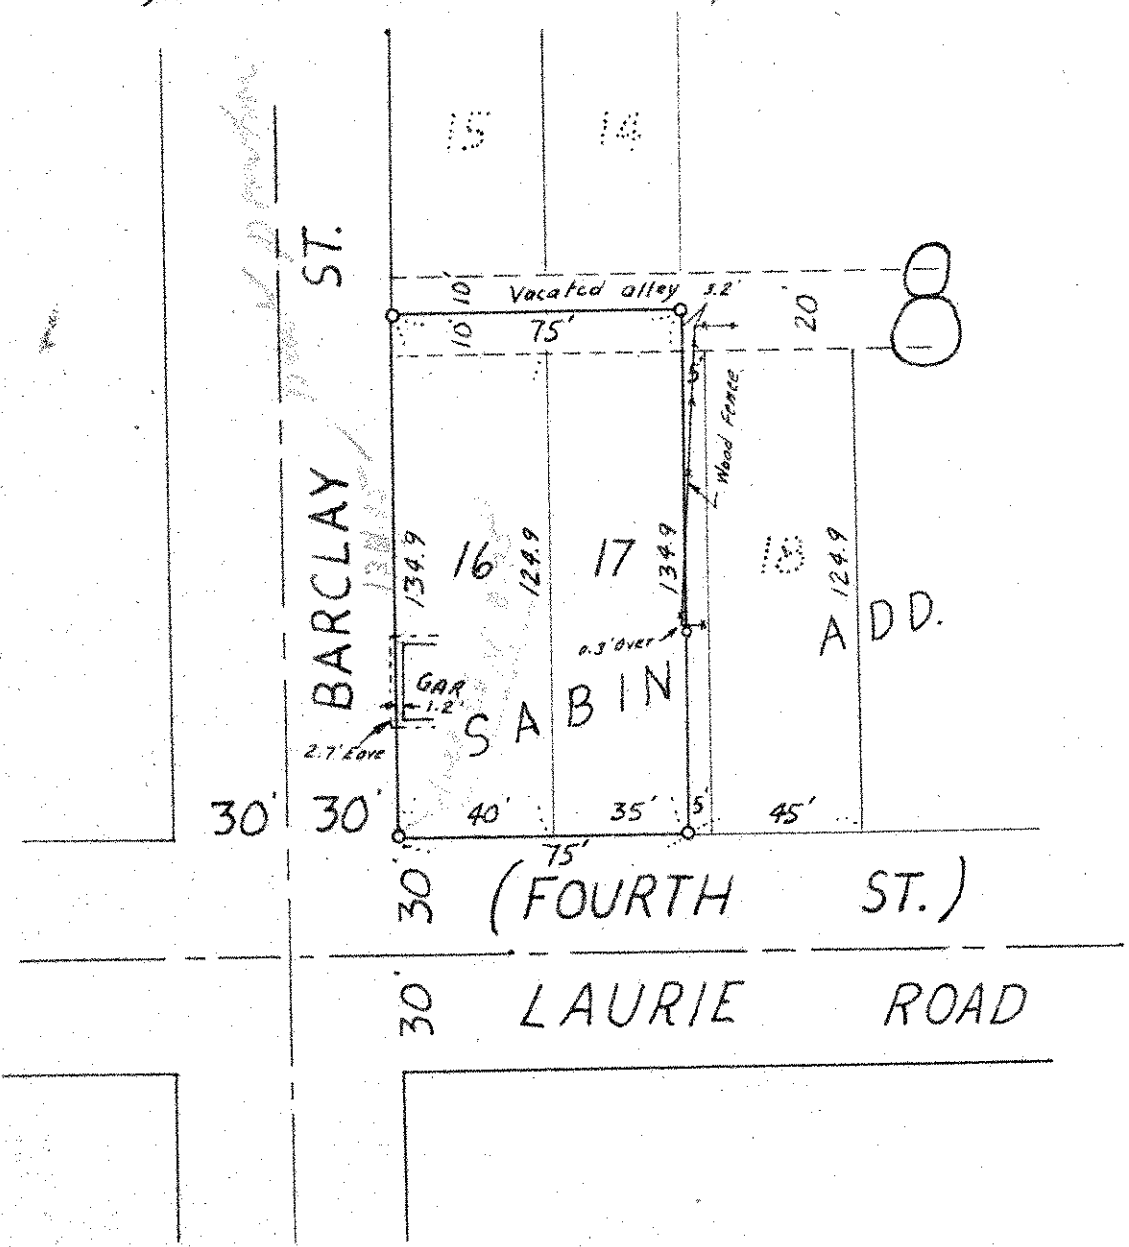

o Denotes Iron Monument