

Appl. 51464

TELEPHONE 776-0640


# PLAT OF SURVEY

OF PROPERTY OF Daniel P. Primoli  
 DESCRIBED AS FOLLOWS Lots 1 and 2, Block 1, Sabin Addition  
No 1528 Cope Ave, Maplewood, Minnesota.

SCALE: 1 INCH = 30 FEET

COPE AVENUE

T. J. WELCH, REGISTERED SURVEYOR  
701 EAST 3RD STREET, ST. PAUL, MINN. 55106

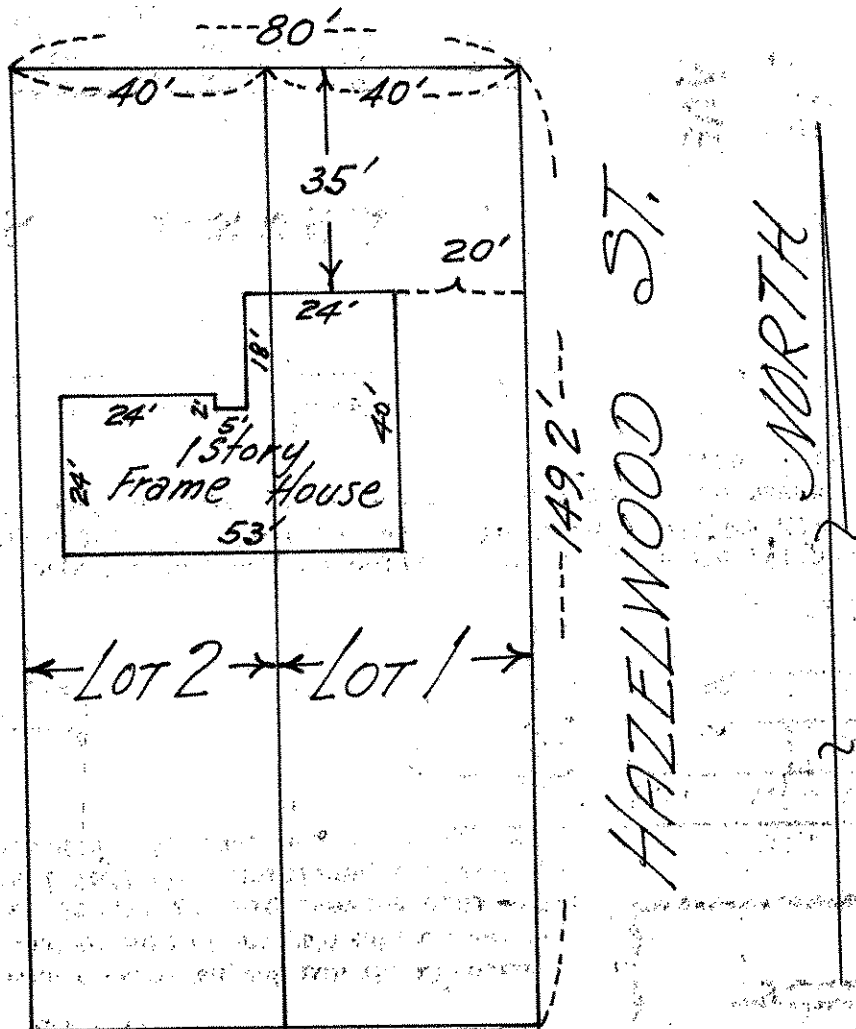

20' ALLEY

### CERTIFICATE OF SURVEY

I hereby certify that on December 26, 1969  
 I surveyed the property described above and that the above  
 plat is a correct representation of said survey.

J. J. Welch

*This survey is made exclusively for  
 First Federal Savings & Loan Assn. of  
 St. Paul. Lot lines are not guaranteed  
 as this is survey for mortgage purposes  
 only.*