


TELEPHONE TOWER 0640

PLAT OF SURVEY

OF PROPERTY OF Arthur W. Emundson
DESCRIBED AS FOLLOWS Lots 4 and 5, Sahlgards Subdivision of
Lot 55, Lake Como Villas.
No. 992 Chatsworth St., St. Paul, Minn.

SCALE: 1 INCH 20 FEET

T. J. WELCH, REGISTERED SURVEYOR
738 SURREY AVENUE, ST. PAUL, MINN.

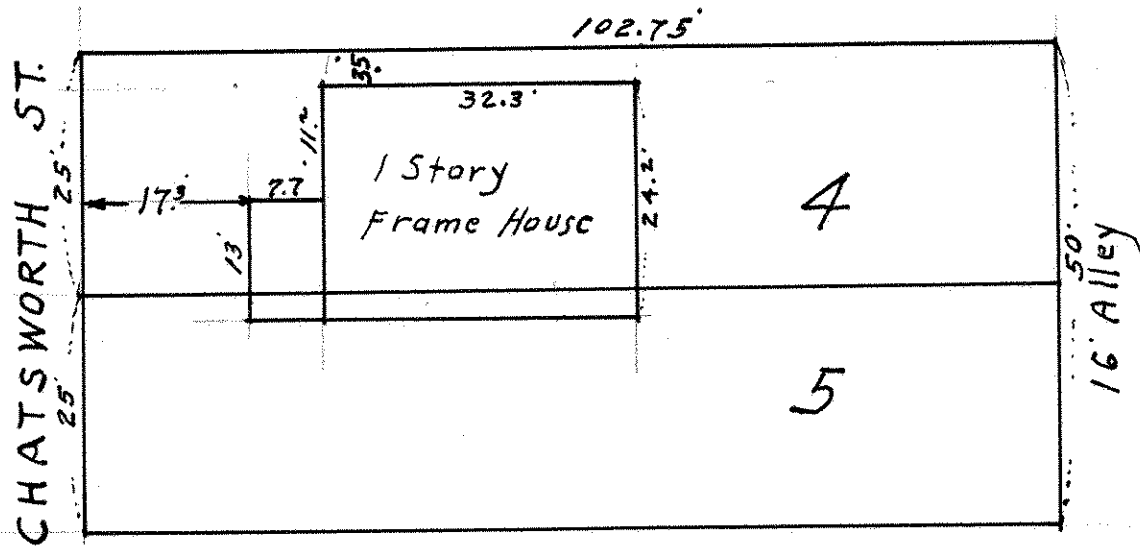

CERTIFICATE OF SURVEY

I hereby certify that on April 19 1943
I surveyed the property described above and that the above
plat is a correct representation of said survey.

T. J. Welch