

Appl. 44124

TELEPHONE 776-0640

PLAT OF SURVEY


OF PROPERTY OF John W. Traeger

DESCRIBED AS FOLLOWS Lot 18 Sahlgard's Subdivision of Lot 55 Lake Como Villas
N 2957 Front St., St. Paul, Minn.

SCALE: 1 INCH = 30 FEET

T. J. WELCH, REGISTERED SURVEYOR
701 EAST 3RD STREET, ST. PAUL, MINN. 55106

20' ALLEY

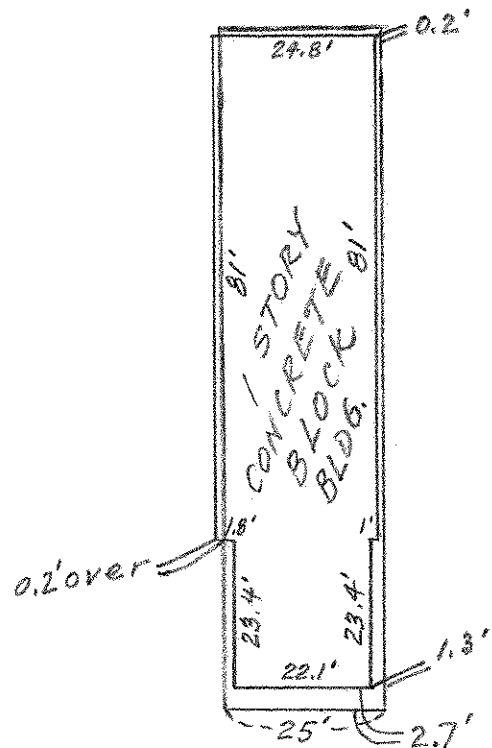

FRONT ST.

CERTIFICATE OF SURVEY

I hereby certify that on Sept. 17, 1965

I surveyed the property described above and that the above plat is a correct representation of said survey.

T. J. Welch

3/5/32