

Appl. 44124

TELEPHONE 776-0640


# PLAT OF SURVEY

OF PROPERTY OF John W. Traeger  
 DESCRIBED AS FOLLOWS The South 26.7 feet of Lot 18, Salhgards' Subdivision of Lot 55  
Lake Como Villas  
Nº 957 Front Street, St. Paul, Minn.

SCALE: 1 INCH = 30 FEET

T. J. WELCH, REGISTERED SURVEYOR  
 701 EAST 3RD STREET, ST. PAUL, MINN. 55106

20' ALLEY

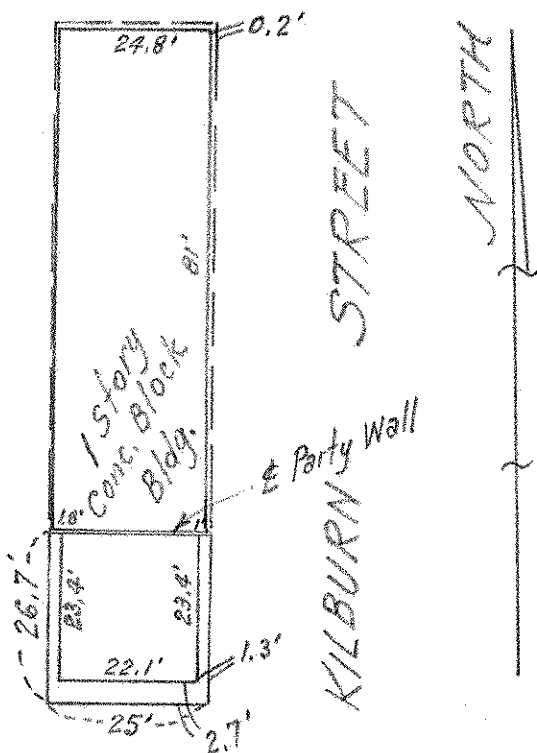

FRONT STREET

### CERTIFICATE OF SURVEY

I hereby certify that on Sept. 17, 1965  
 I surveyed the property described above and that the above  
 plat is a correct representation of said survey.

T. J. Welch

3/5/32