


NORTH 1/2 SOUTH 1/2 NORTH WEST 1/4

SECTION 33, TOWN 30, RANGE 22,

JOHN B. IRVINE, SURVEYOR.
408 GLOBE BLDG.
ST. PAUL, MINN.
APRIL 16-1913.

Scale 200 ft. per inch.

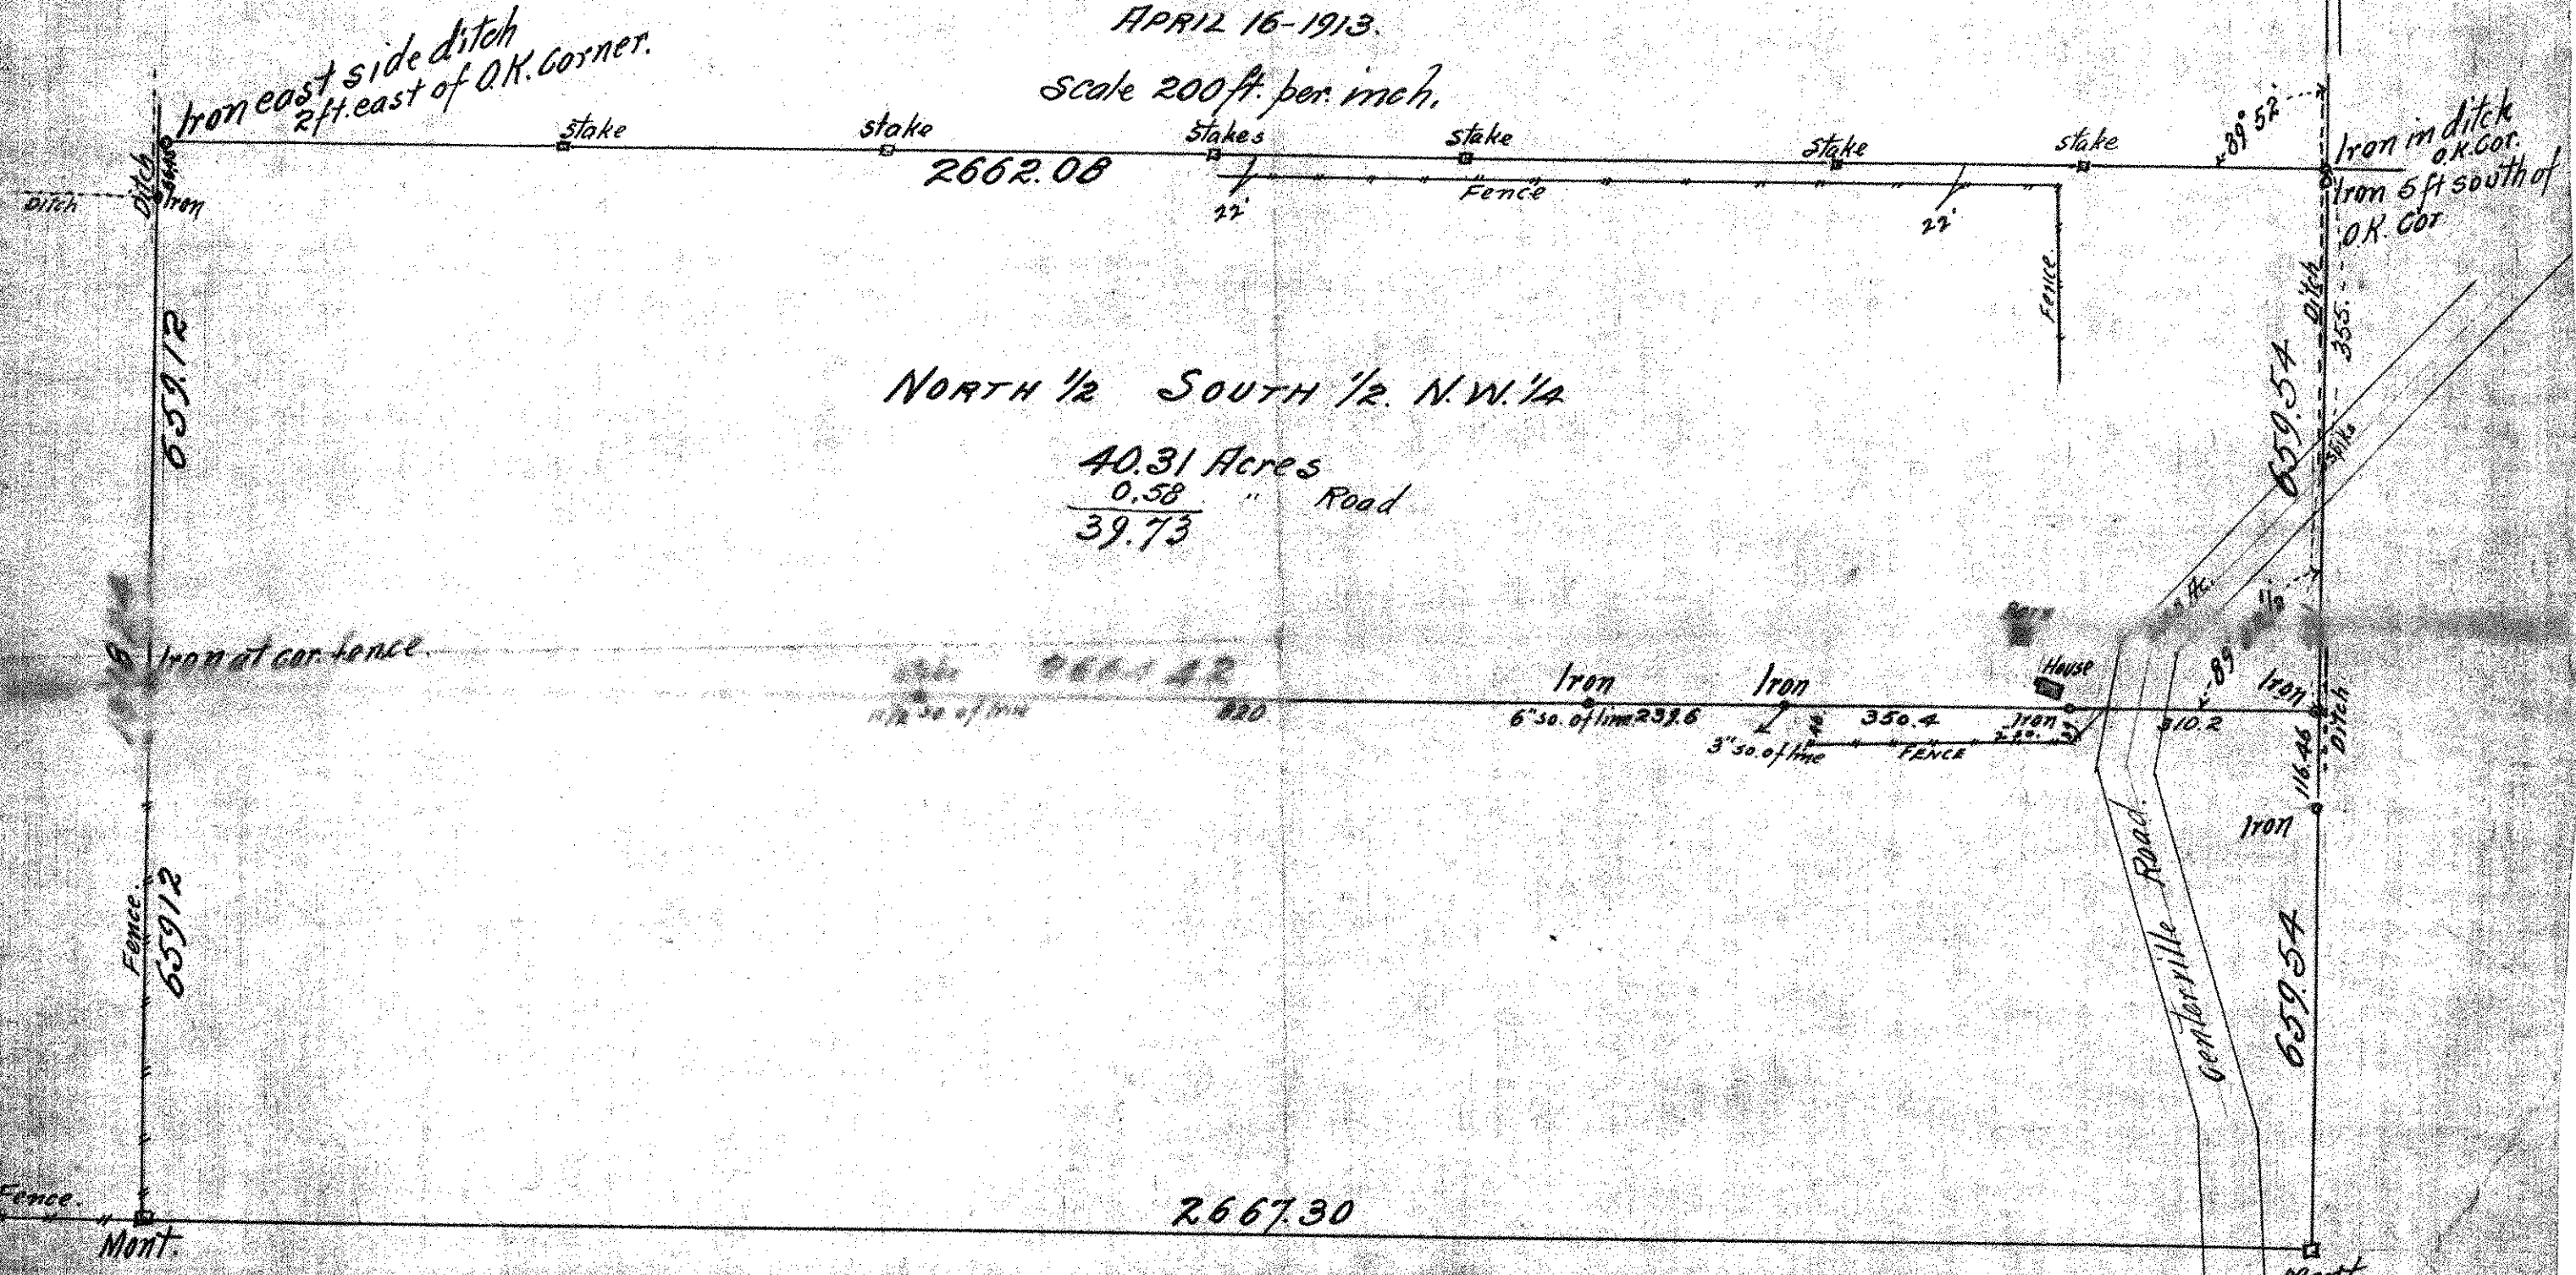

NORTH 1/2 SOUTH 1/2 N.W. 1/4

40.31 Acres
0.58 " Road
39.73

Iron east side ditch
2 ft. east of O.K. corner.

Iron in ditch
O.K. Cor.
Iron 5 ft south of
O.K. Cor.

Iron at cor. fence.

House

Genterville Road.

2667.30

2662.08

6591.2

6591.2

659.54

659.54

6" 50. of line 238.6

3" 50. of line 350.4

510.2





