NW 28 29 23

Certificate of Survey

6/17/76 4 PRINTS TO

FROM THE OFFICE OF

CHARLES O. GEORGI COMPANY

2215 West County Road B Saint Paul, Minnesota 55113

REGISTERED CIVIL ENGINEER AND LAND SURVEYOR

I Hereby Certify that **this plat shows a survey made by me of the property described on this plat, and that the corners are correctly placed as shown, and that all locations have been correctly shown.**

Surveyed For Twin City Linnea Home Lutheran Church of America
Arnold E. Graber, Executive Director

Date June 1976

Scale 1" = 40'

By Charles O. Georgi
REGISTERED LAND SURVEYOR

6/17/76 Added Lot 4, Elder's 2nd Re.

Description:

Lots 1, 2, 3, and 4, Block 16, St. Anthony Park,
and Lot 4, Elder's 2nd Reorrangement,
Ramsey County, Minnesota

o Denotes Iron Monument
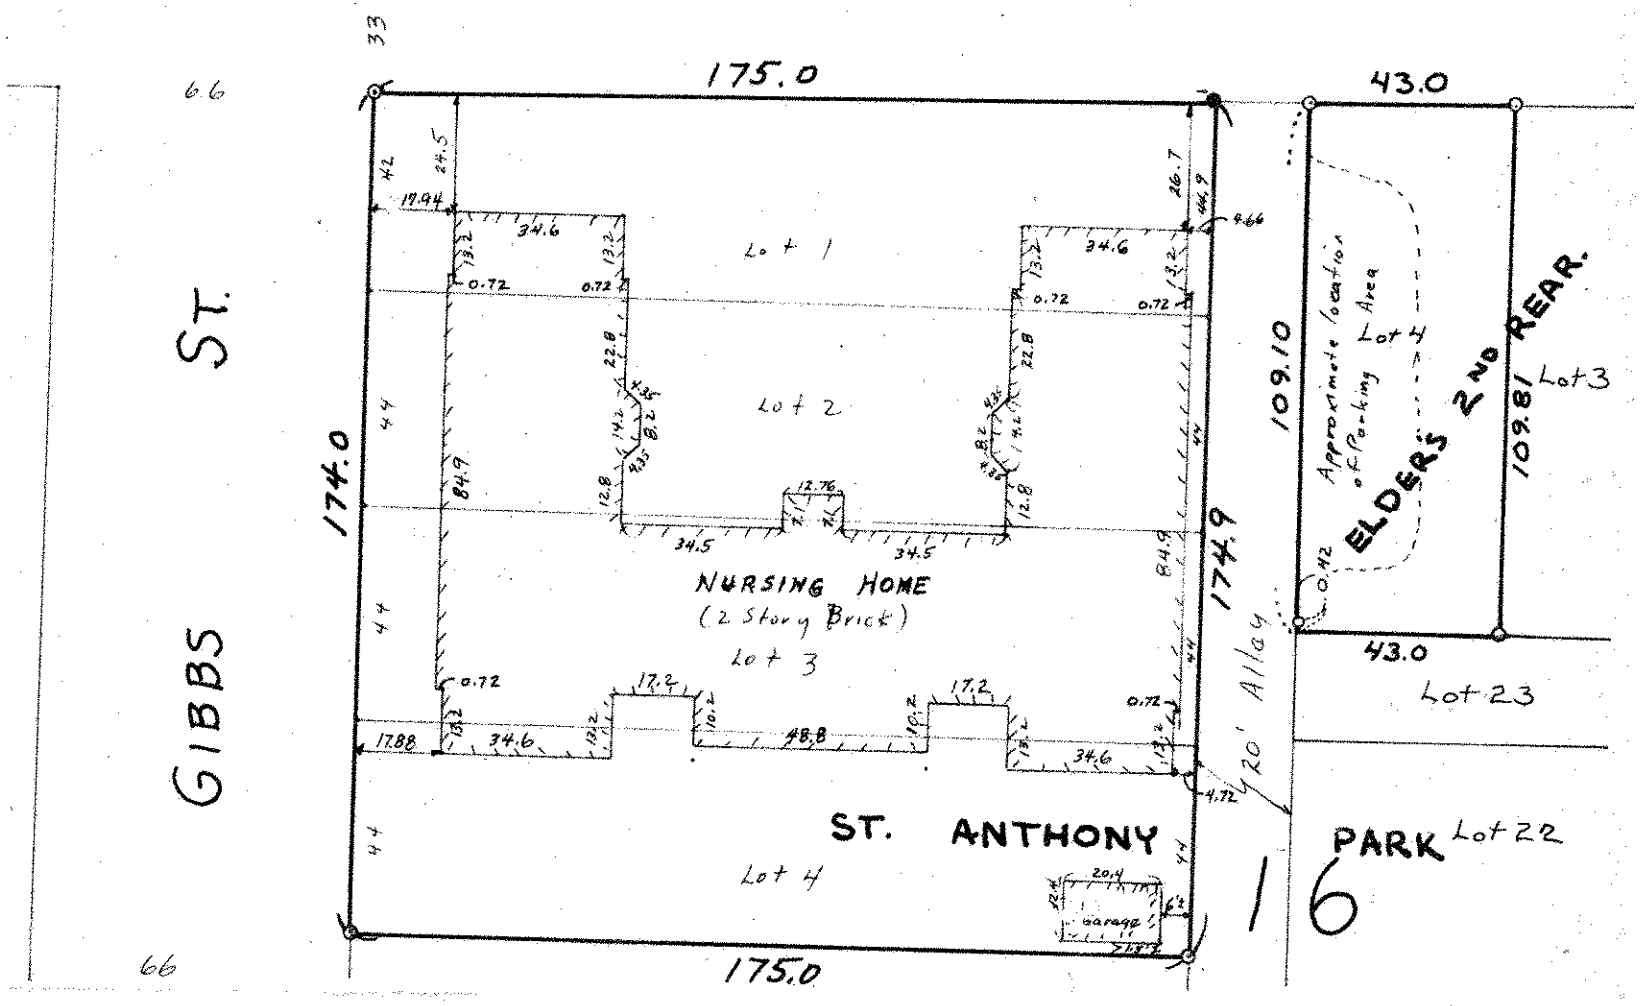
• Denotes Iron Monument found in place