


PLAT OF SURVEY

OF PROPERTY OF _____

DESCRIBED AS FOLLOWS Lot 11 Block 15 St. Anthony Park

SCALE: 1 INCH = 30 FEET
o DENOTES IRON.

T. J. WELCH, REGISTERED SURVEYOR
738 SURREY AVENUE, ST. PAUL 6, MINN.

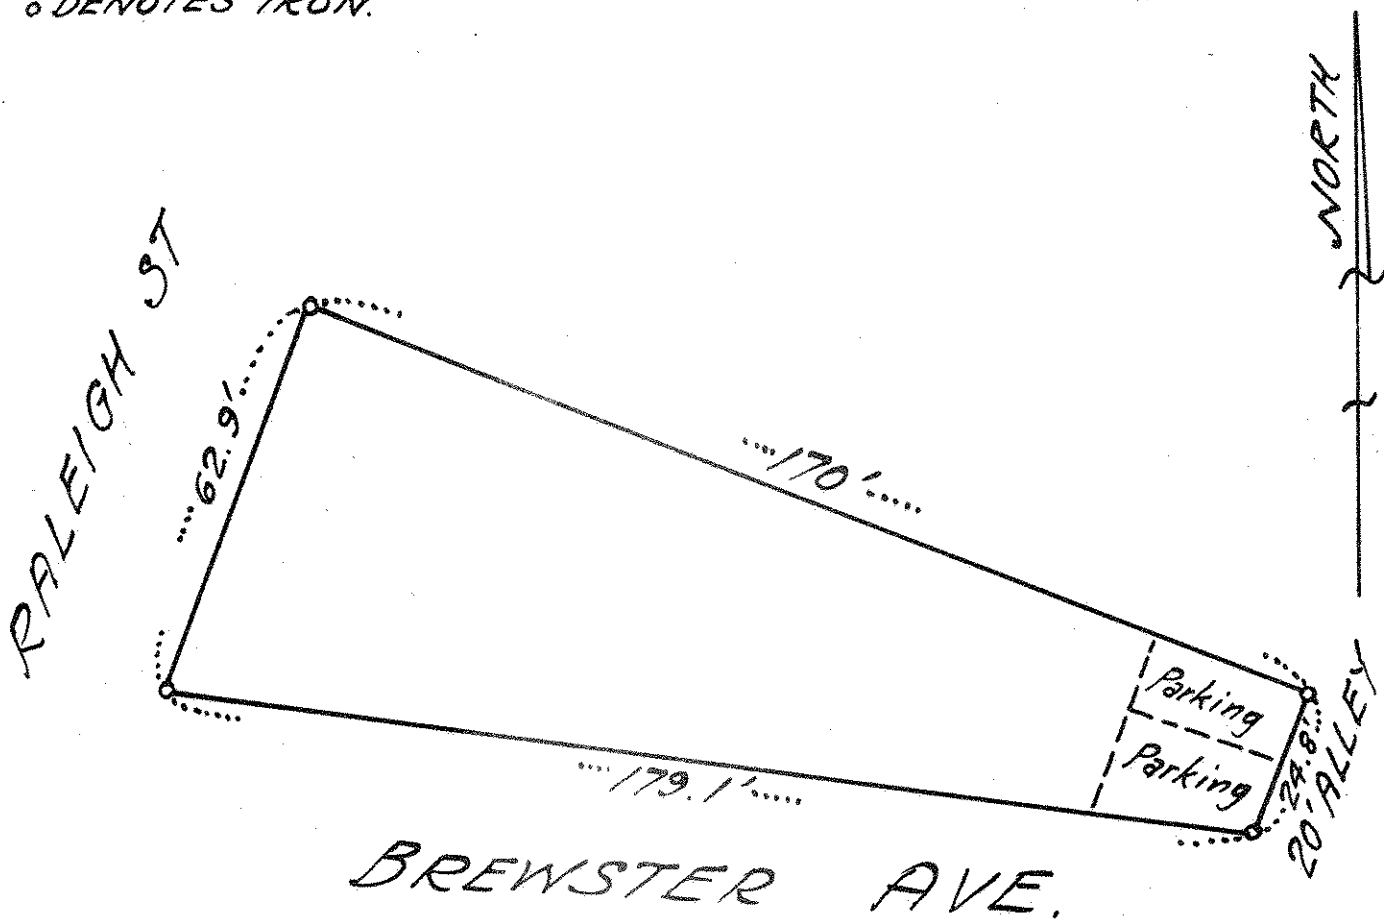

CERTIFICATE OF SURVEY

I hereby certify that on 7-11, 19 61
I surveyed the property described above and that the above
plat is a correct representation of said survey.

J. J. Welch