


LOT 12 BLOCK 38
ST. ANTHONY PARK,

PLAT I,
JOHN B. IRVINE, SURVEYOR.
APRIL 16-1914.

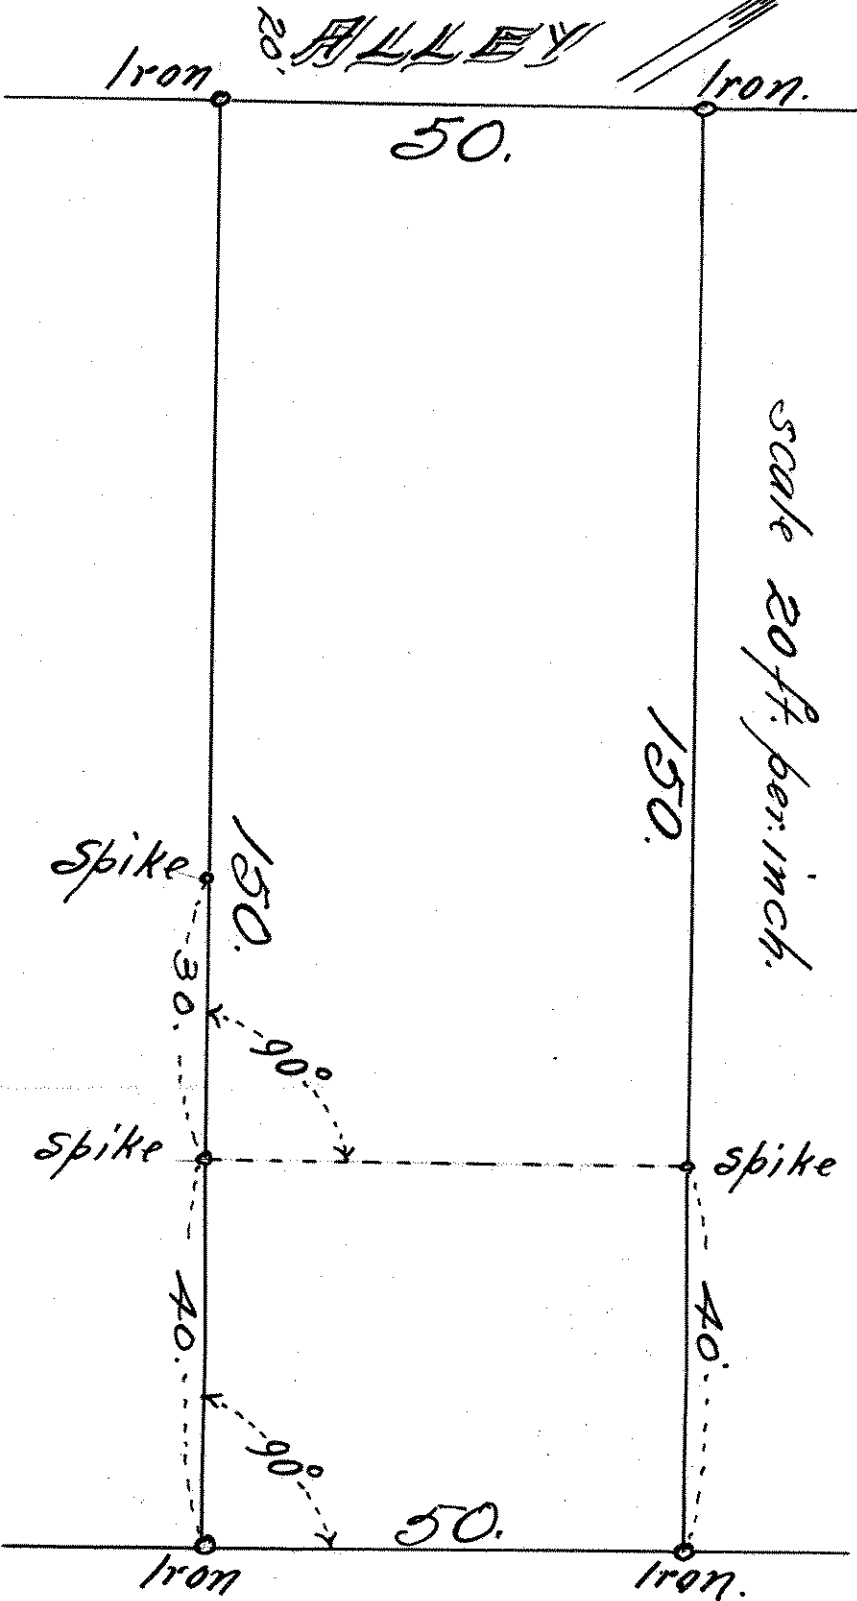

LANGFORD PK. PL. W.