

LOT 20 BLOCK 38

ST. ANTHONY

PARK


JOHN B. IRVINE, SURVEYOR.

ST. PAUL, MINN.

JUNE 27-1916.

Scale 20ft. per inch.

ALLEY

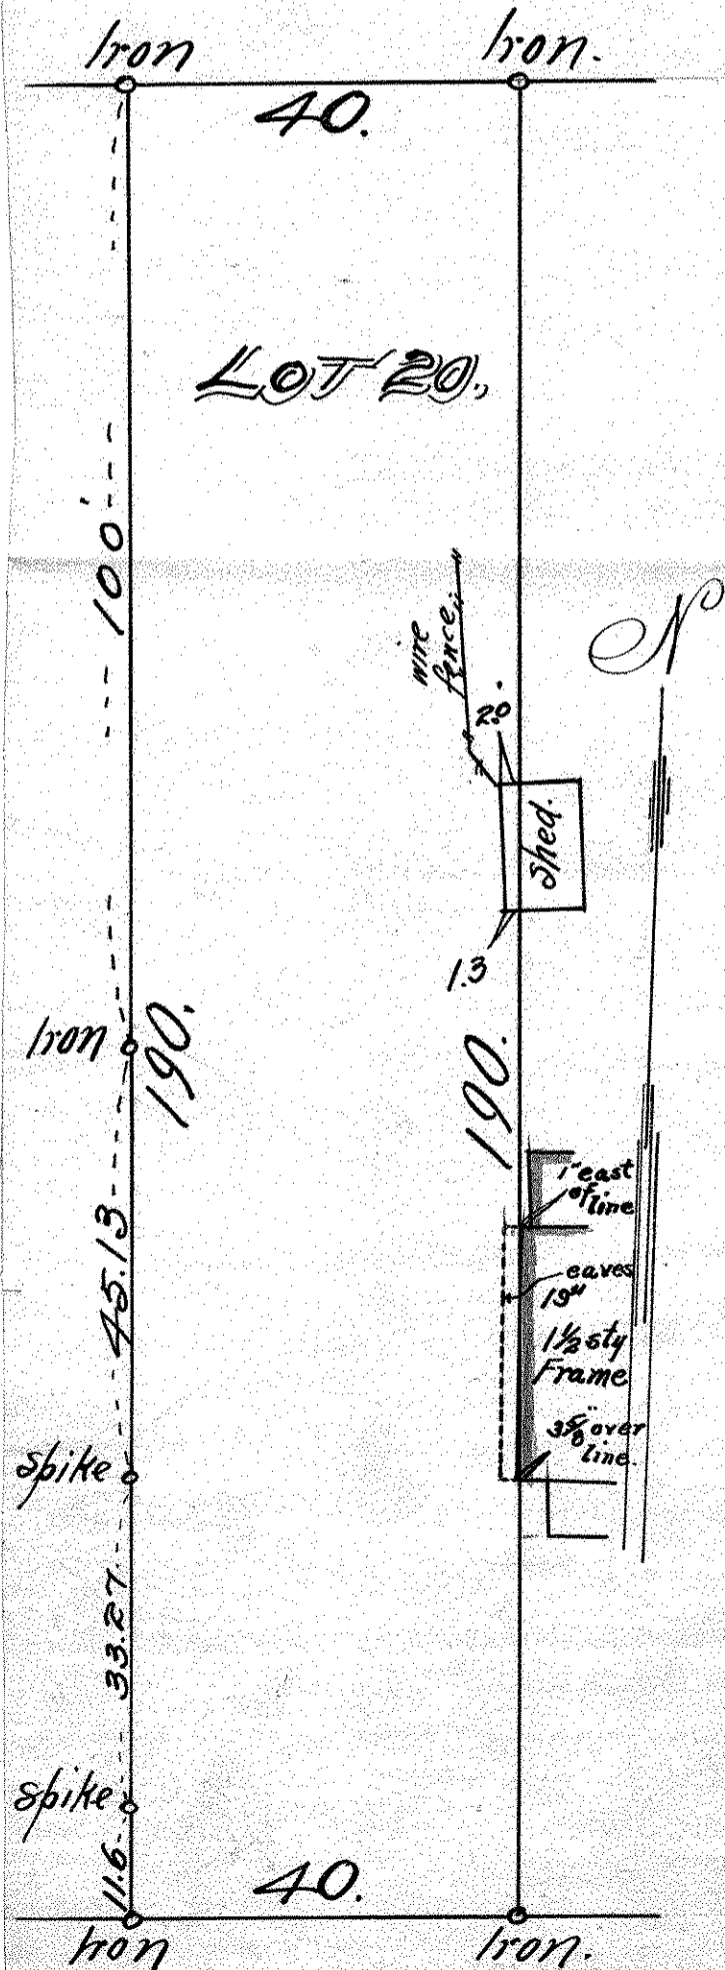

GORDON AVE.