


# LOT 15 BLOCK 38 ST ANTHONY PARK,

JOHN B. IRVINE SURVEYOR.  
416 GLOBE BLDG.  
ST PAUL MINN  
SEPT. 5.-06.

SCALE 1/IN = 20 FT.

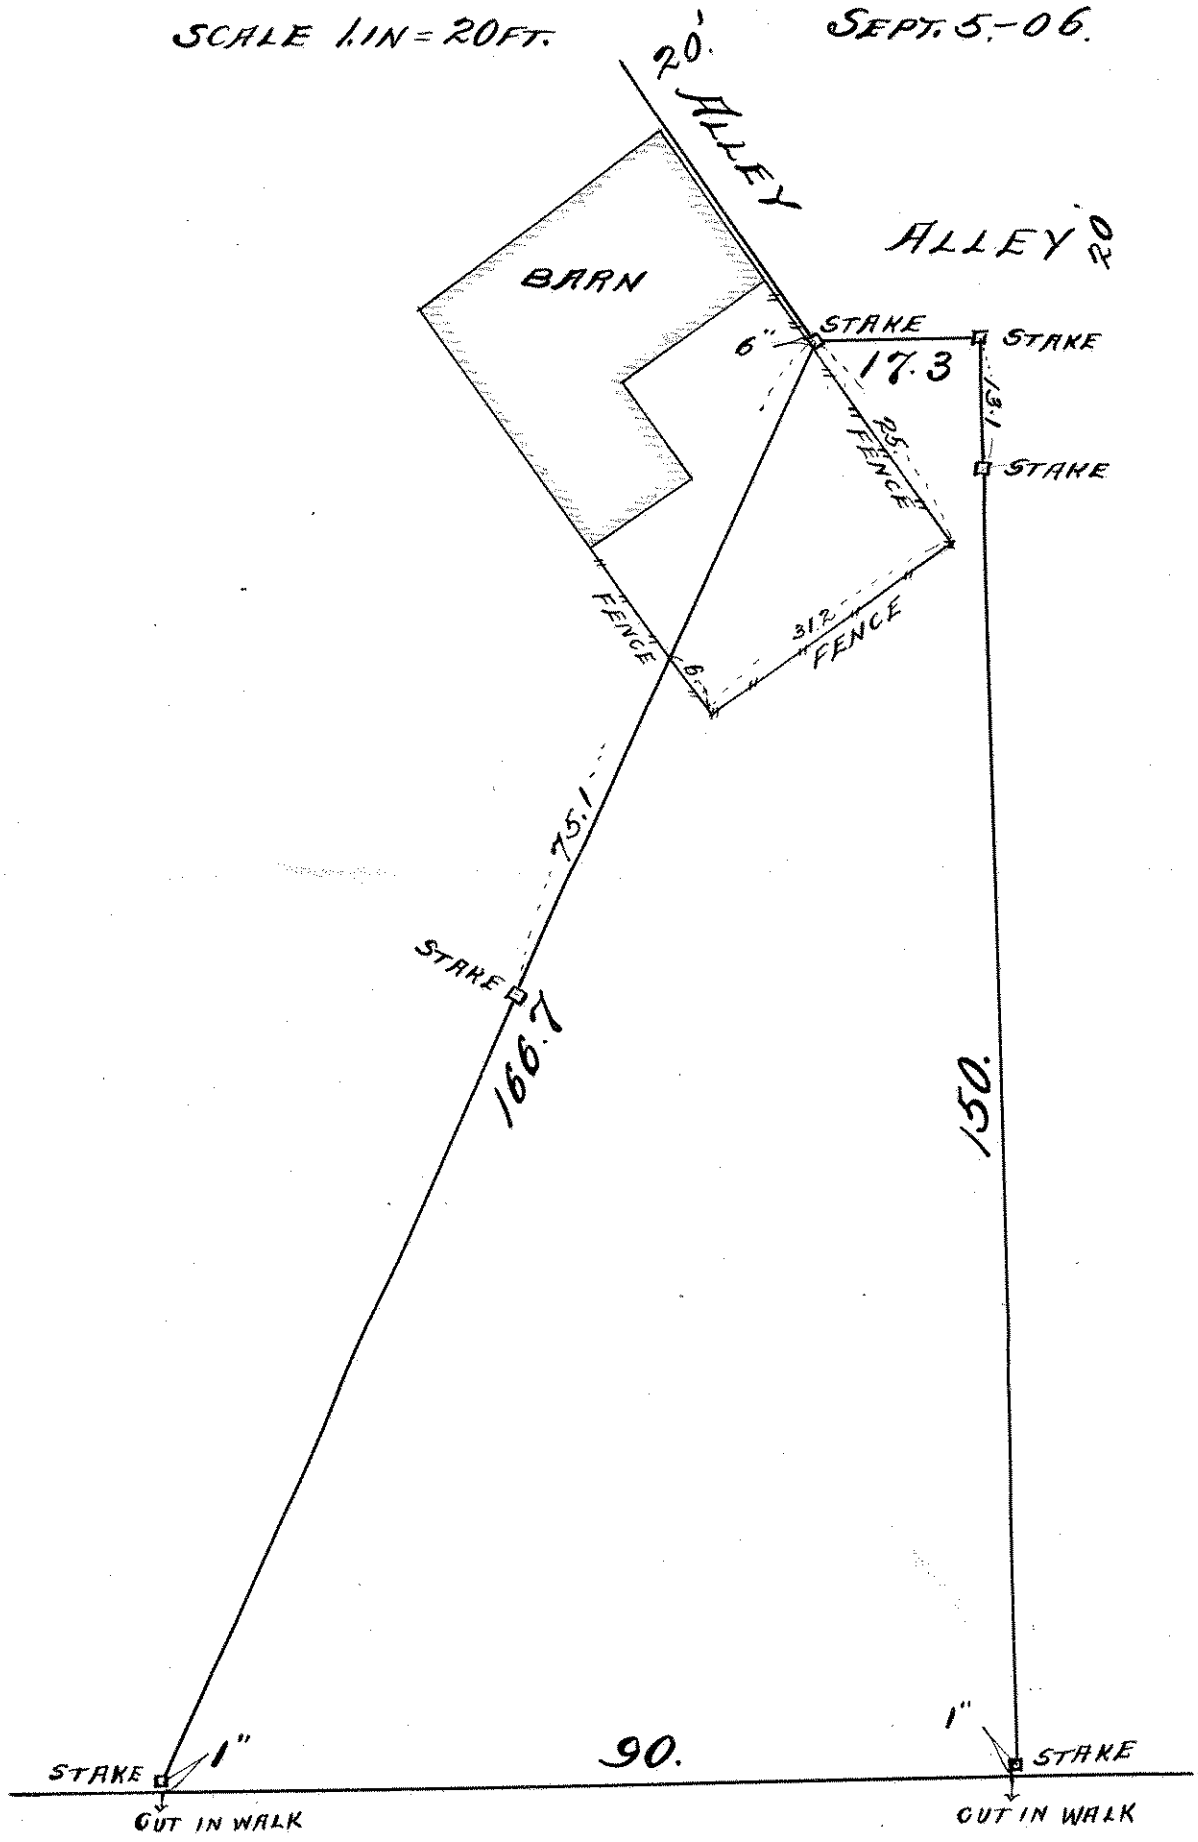

LANGFORD PARK PLACE WEST