


LOTS 1 & 2 BLOCK 43
ST. ANTHONY PARK

SUR Apr. 27^m'03
A.R. McGill.

30 Ft. = 1 in.

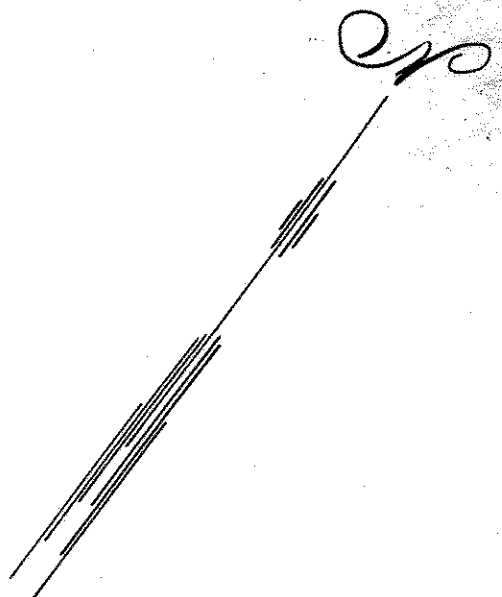

ATTY ST.

