


11/24/05
Map

LOTS 7-8-9 BLK.44 ST ANTHONY PARK

JOHN B. IRVINE, SURVEYOR.
ROOM 508 GLOBE BLD'G
ST PAUL MINN.
MAY 23-05

□ INDICATES STAKES
SCALE 1 IN. = 20 FT.

SCUDDER AVE.

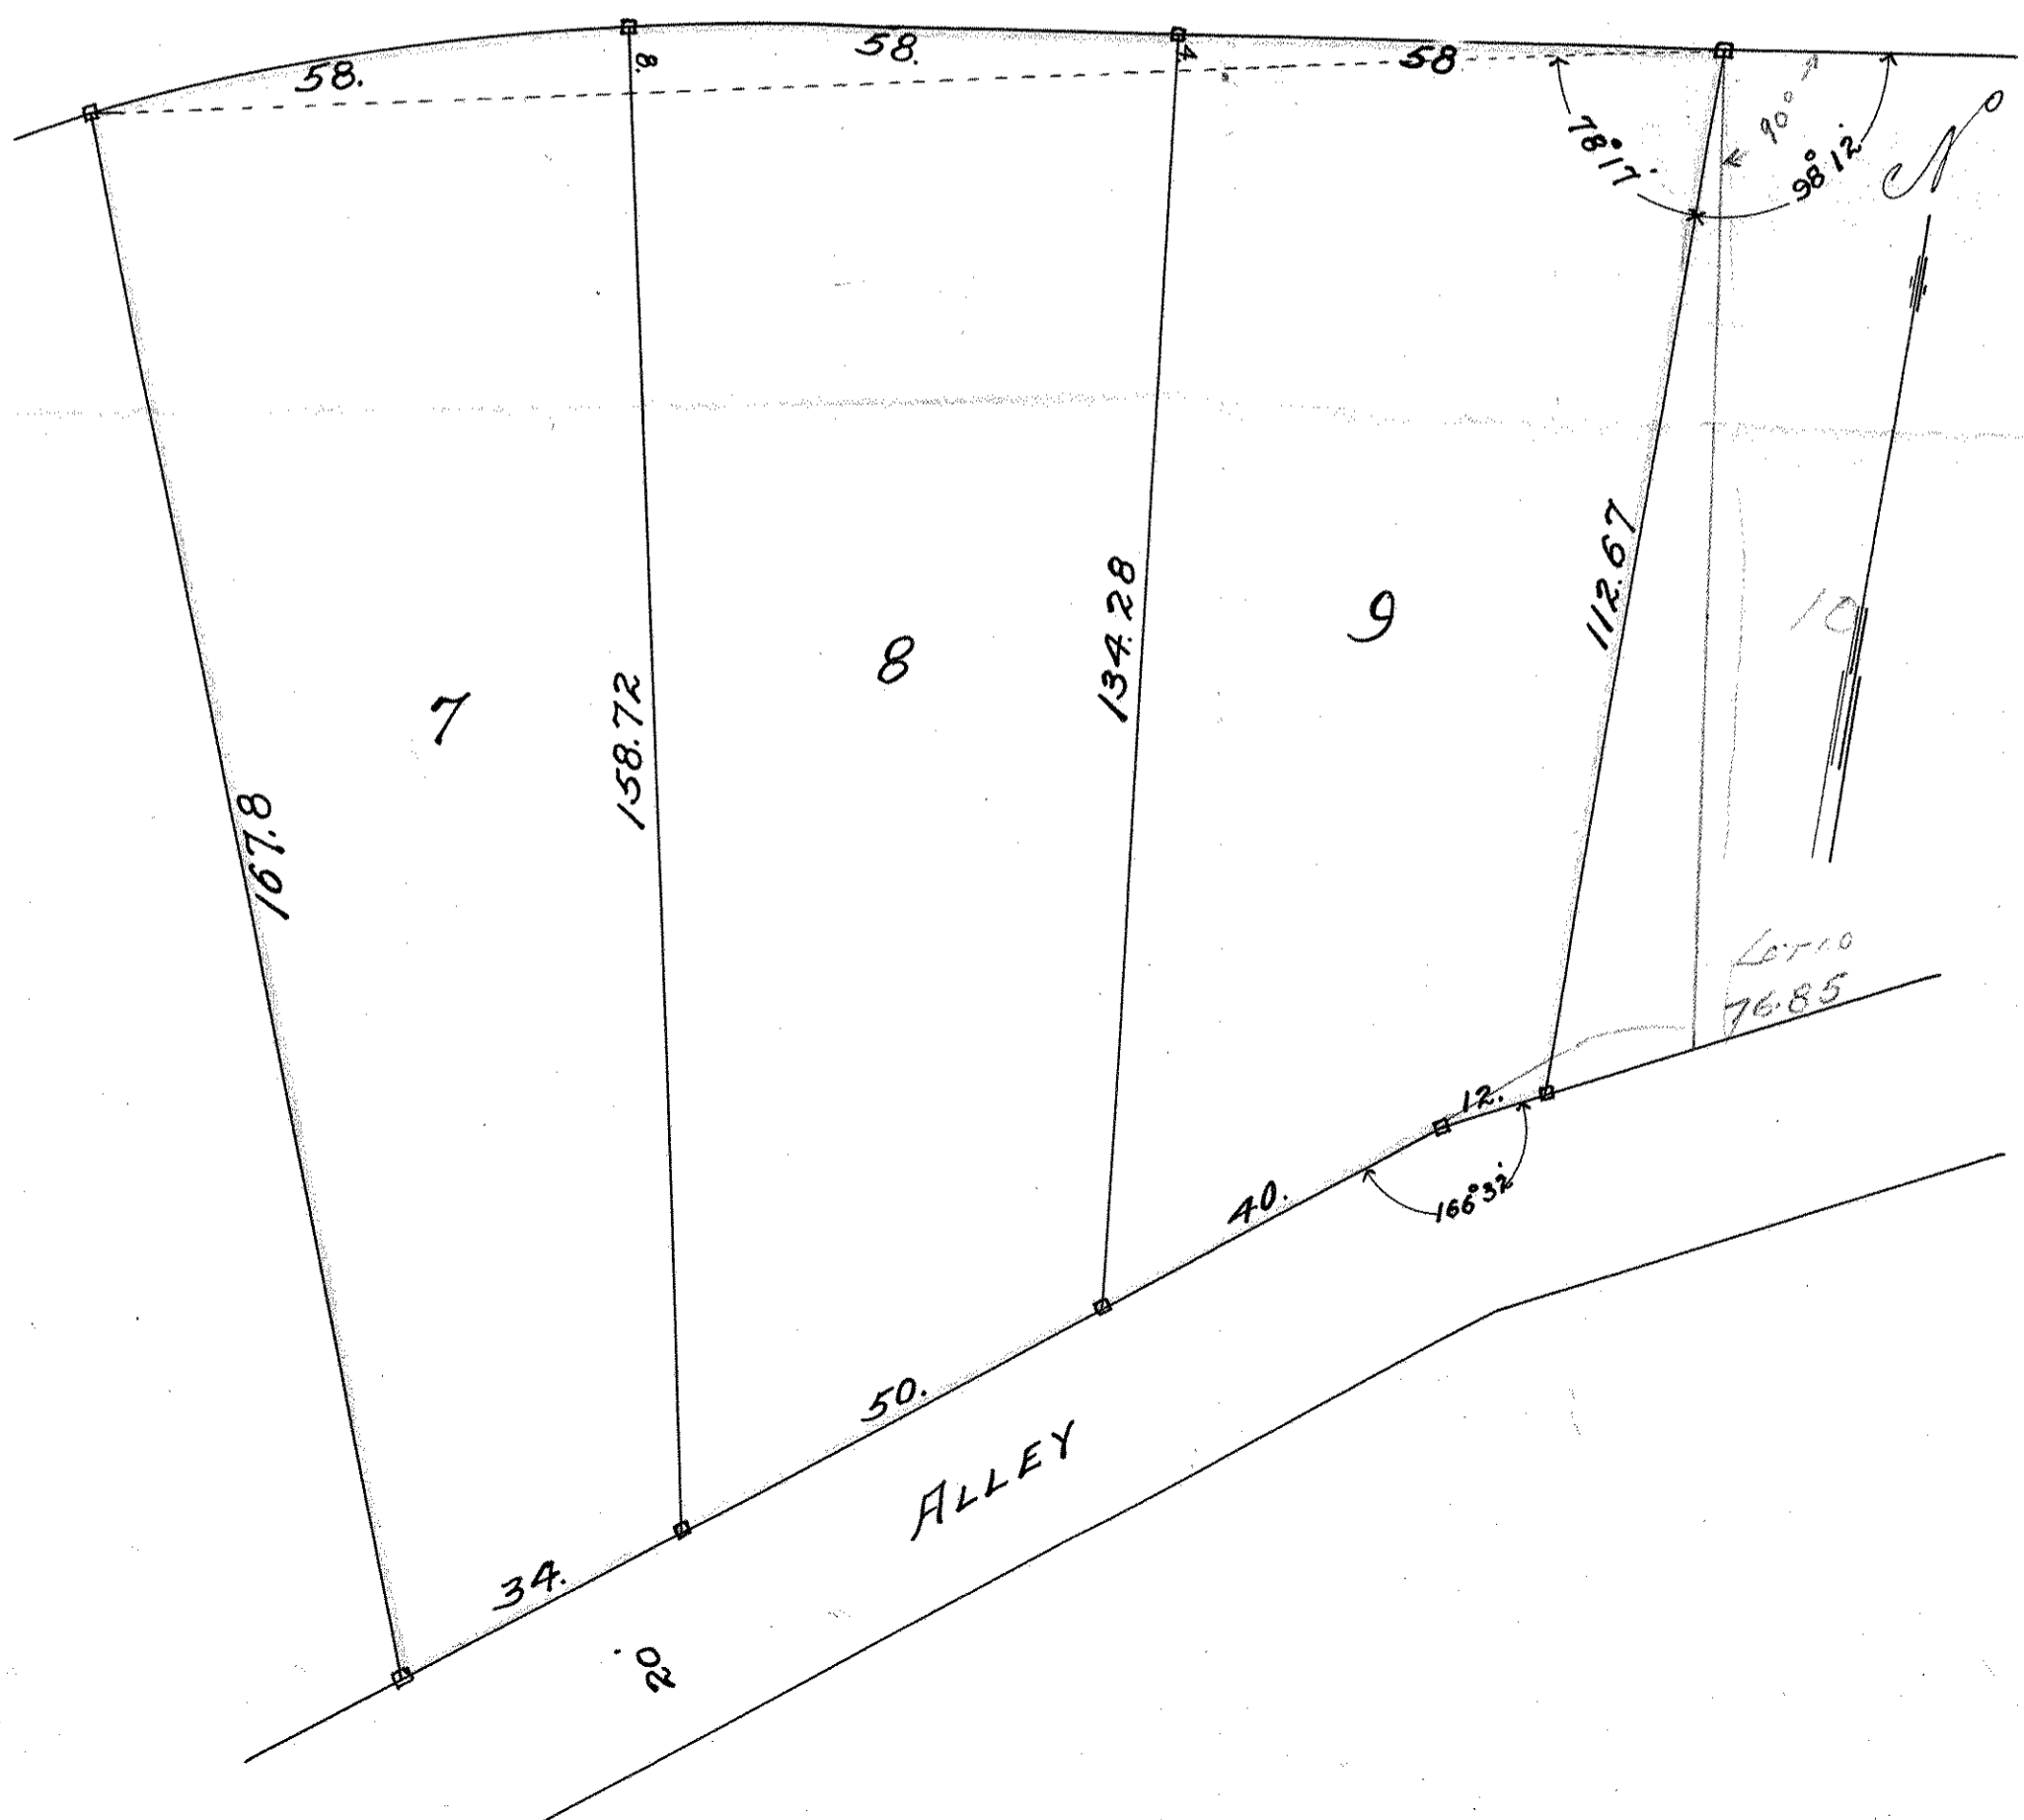

Lot 11
8845