

FROM THE OFFICE OF

CHARLES O. GEORGI COMPANY

2215 West County Road B

Saint Paul, Minnesota 55113

REGISTERED CIVIL ENGINEER AND LAND SURVEYOR

Certificate of Survey

I Hereby Certify that this plat shows a survey made by me of the property described on this plat, and that the corners are correctly placed as shown, and that all locations have been correctly shown.

Surveyed For Norman Gilbert
Date March 1972
Scale 1" = 30'

By Charles O. Georgi
REGISTERED LAND SURVEYOR

Description:
The Southwesterly 1/2 of lot 3, Subdivision of lots 16 and 17,
Block 44 St. Anthony Park, except the Northeastly
~~100~~ ⁵⁰ feet of the Northwestly ~~70~~ ⁴² feet thereof,
and lot 1, Subdivision of lots 18 and 19,
Block 44, St. Anthony Park.

Ramsey County, Minnesota

Contains 6,900 Sq. Ft. more or less.

For Condo

A1-


This one -

Locate & set 3 corners -

Angle -

Locate lot -

If Gilbert there -
Get inside fence

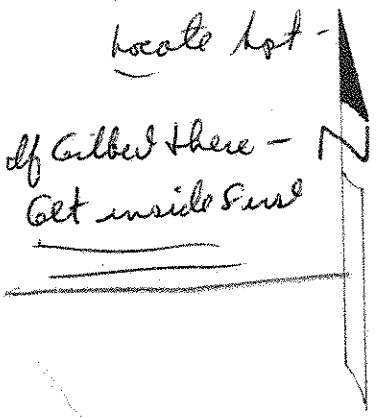

o Denotes Iron Monument

