

Certificate of Safety

CHARLES O. GEORGI COMPANY

2213 West County Road B

Saint Paul 13, Minnesota

REGISTERED CIVIL ENGINEER AND LAND SURVEYOR

I Hereby Certify that this plat shows a survey made by me of the property described on this plat, and that the corners are correctly placed as shown, and that all locations have been correctly shown.

Searched For DALE & GILBERT

Date Feb 1962

Scale 1" = 50'

REGISTERED LAND SURVEYOR

REGISTERED LAND SURVEYOR

Description.

Lot 2 and the North easterly 1/2 of lot 3

Subdivision of Lots 16 and 17

Block 44

St. Anthony Park

② Place aside I.P.
& cut for

The Southwesterly 1/2 of Lot 3

Subdivision of Lots 16 and 17, Block 44


St. Anthony Park

and Lot 1


of the Northwesterly 30 feet
thereof.

Norman Gilbert
1650 W. Skillman
Ave.
St Paul, Minn.
55113

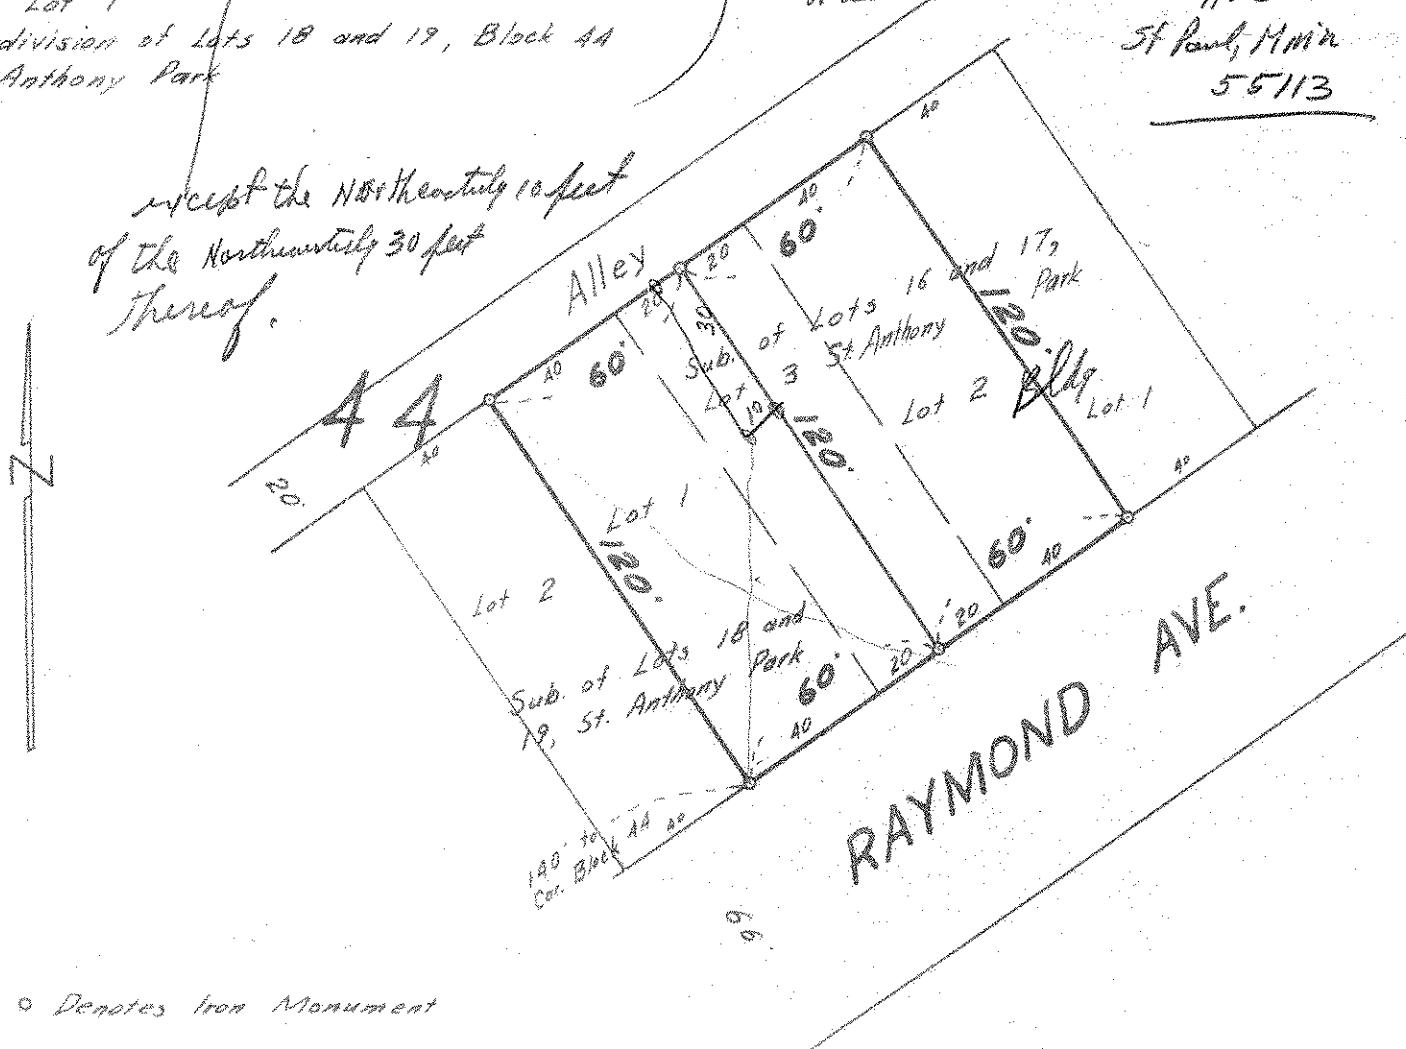

• Denotes Iron Monument