


TELEPHONE PR 6-0640

PLAT OF SURVEY

OF PROPERTY OF _____
 DESCRIBED AS FOLLOWS Lot 8 Block 41 St. Anthony Park together with that
part of all the vacated alley lying Southwesterly of said Lot 8.

SCALE: 1 INCH = 40 FEET
 o DENOTES IRON

T. J. WELCH, REGISTERED SURVEYOR
 738 SURREY AVENUE, ST. PAUL 6, MINN.

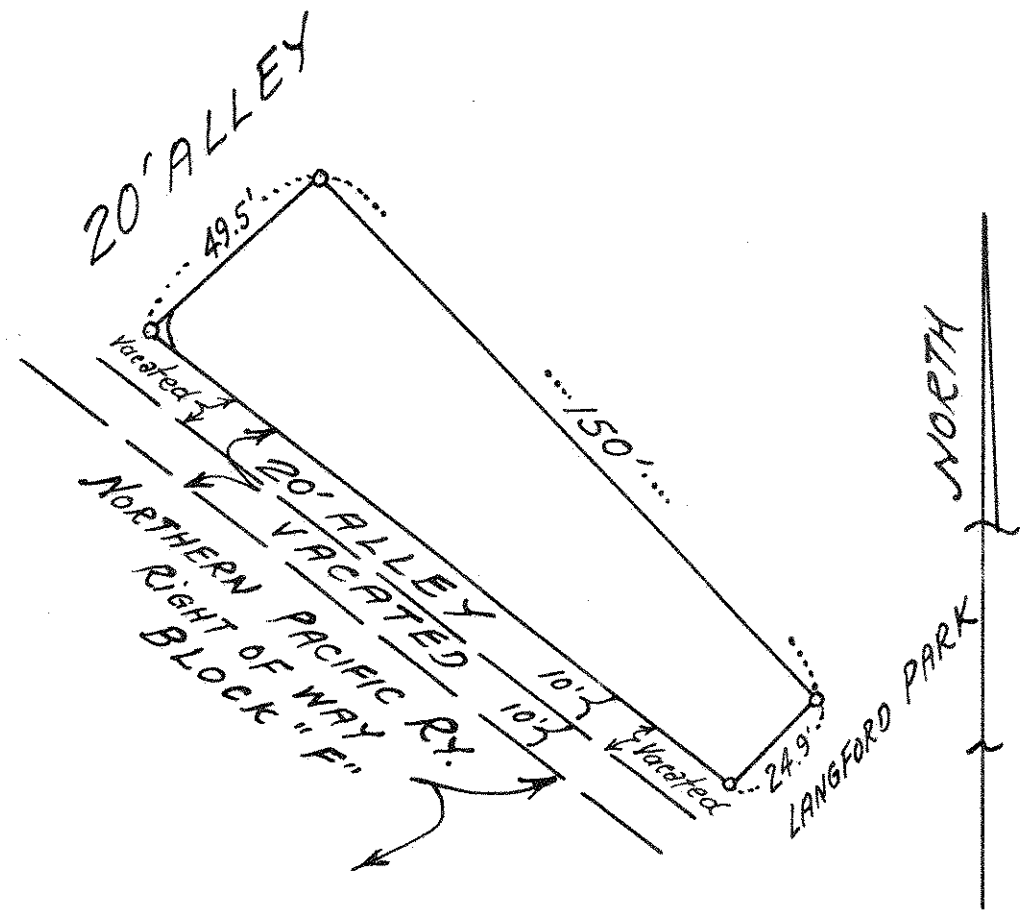

CERTIFICATE OF SURVEY

I hereby certify that on 10-13 1961
 I surveyed the property described above and that the above
 plat is a correct representation of said survey.

T. J. Welch