

# PLAT OF SURVEY


OF PROPERTY OF *Mrs. Lawrence Boyer.*

DESCRIBED AS FOLLOWS *Lot 5, Block 41 St Anthony Park  
No. 16 Ludlow Ave. St. Paul, Minn.*

SCALE: 1 INCH 30 FEET

○ Indicates Iron

T. J. WELLS, SURVEYOR  
738 N. 5th St. St. Paul, Minn.

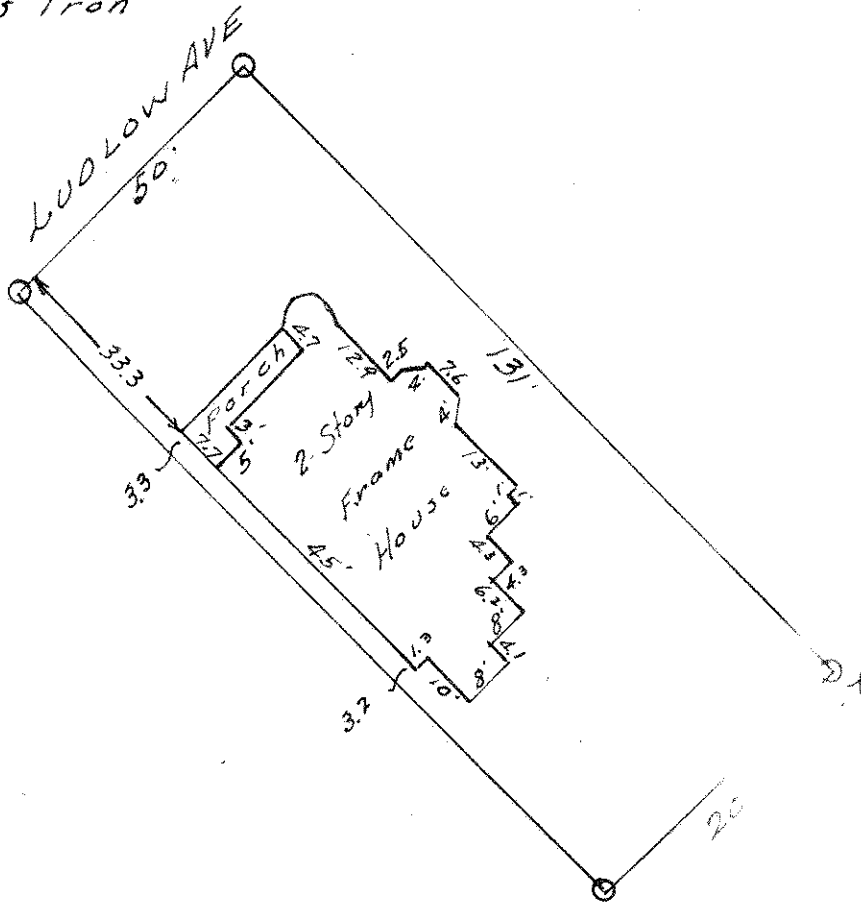

NORTH  
S

CERTIFICATE NO. 43

I hereby certify that on *Nov 29* 19*43*

I surveyed the property and that the above plat is a correct representation of the same.

*T. J. Wells*