

LOT 2 BLOCK 42.

STANTHONY PARK.

JOHN B. IRVINE, SURVEYOR.


408 GLOBE BLD'G.

ST. PAUL, MINN.

OCT. 14-1911.

SCALE 20ft. per. inch.

LANGFORD PK. PLAGE E.

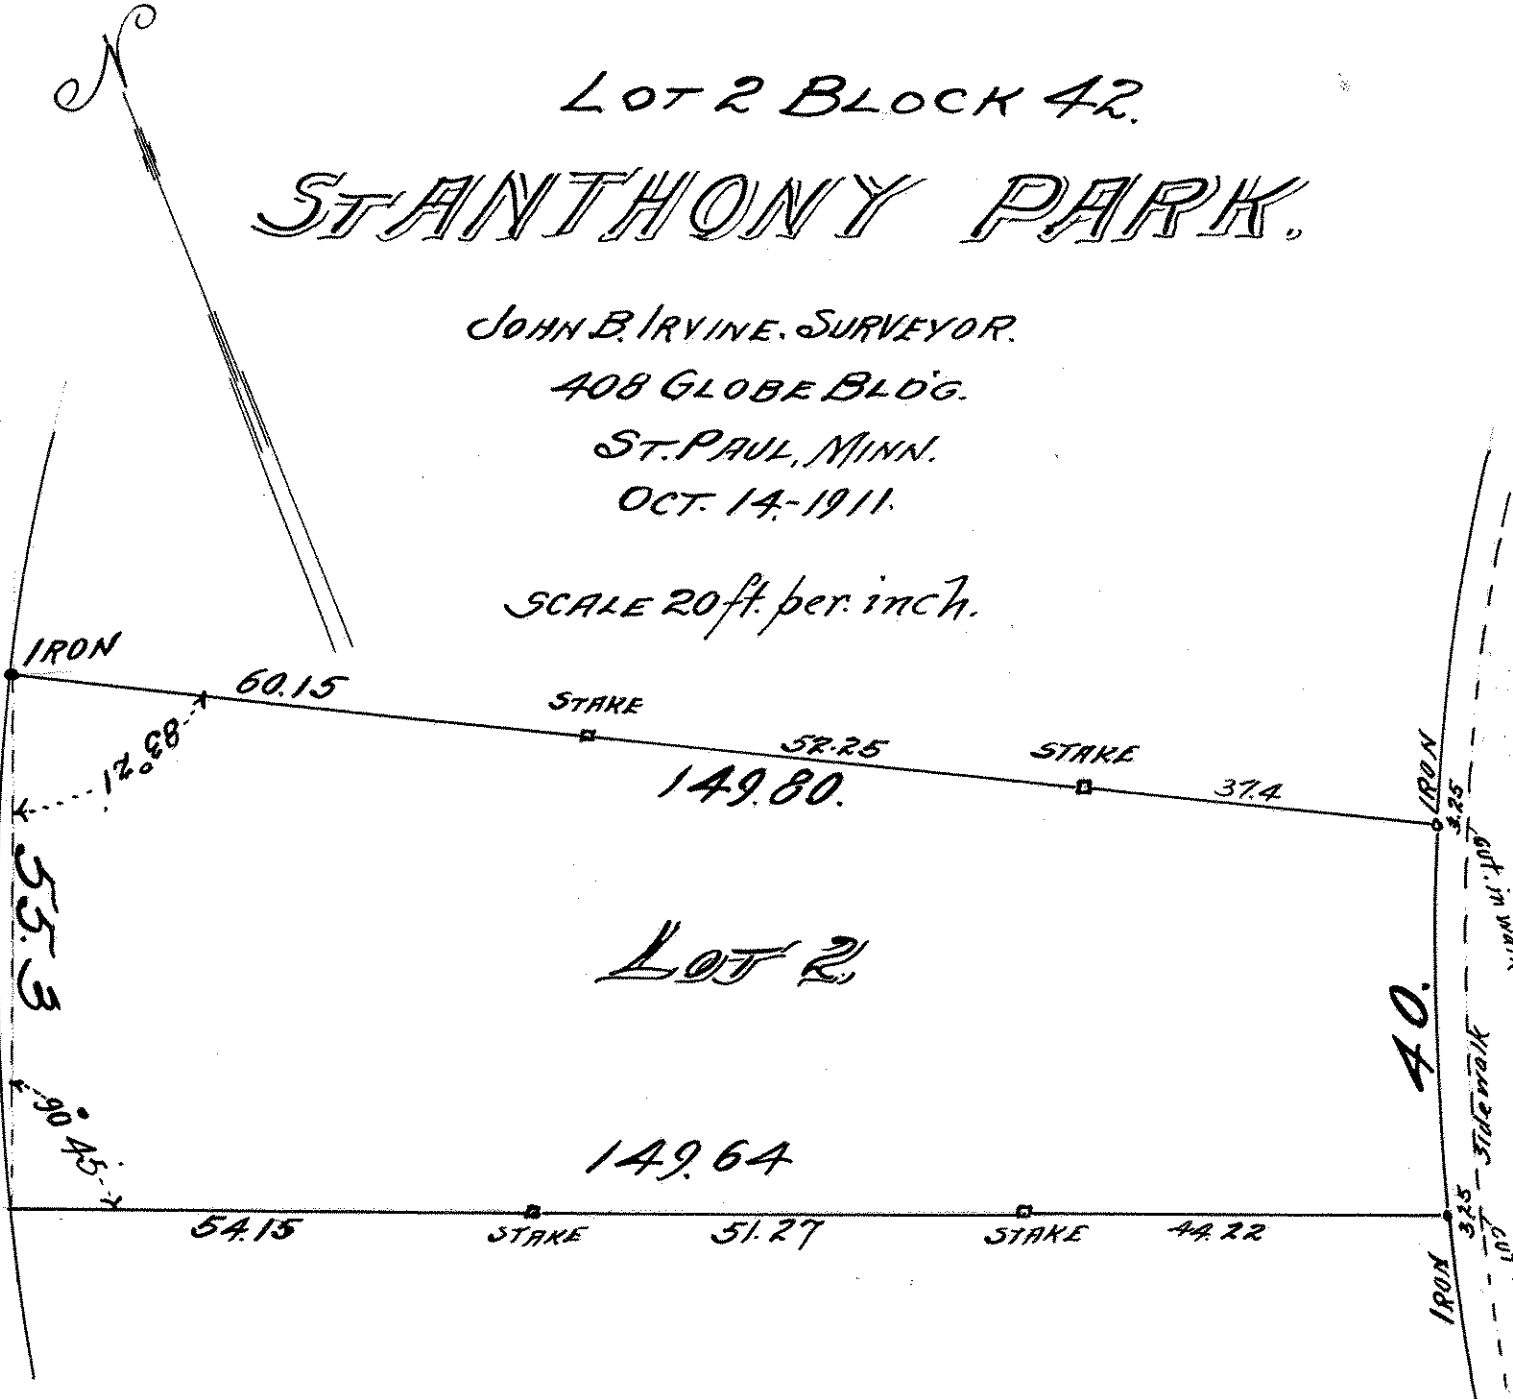

149.80.

LOT 2

149.64

SCUDDER ST.

IRON

IRON

IRON

STAKE

STAKE

STAKE

STAKE

60.15

37.4

55.3

40.

54.15

51.27

44.22

83° 21'

90° 45'

52.25

cut in walk

new steps

ST

cut in walk