LOT 18 BLOCK 73
ST. ANTHONY PARK

Scale 20 Ft. pr. inch

Surv. Apr. 10th 1903

For St. Anthony Furniture Co.

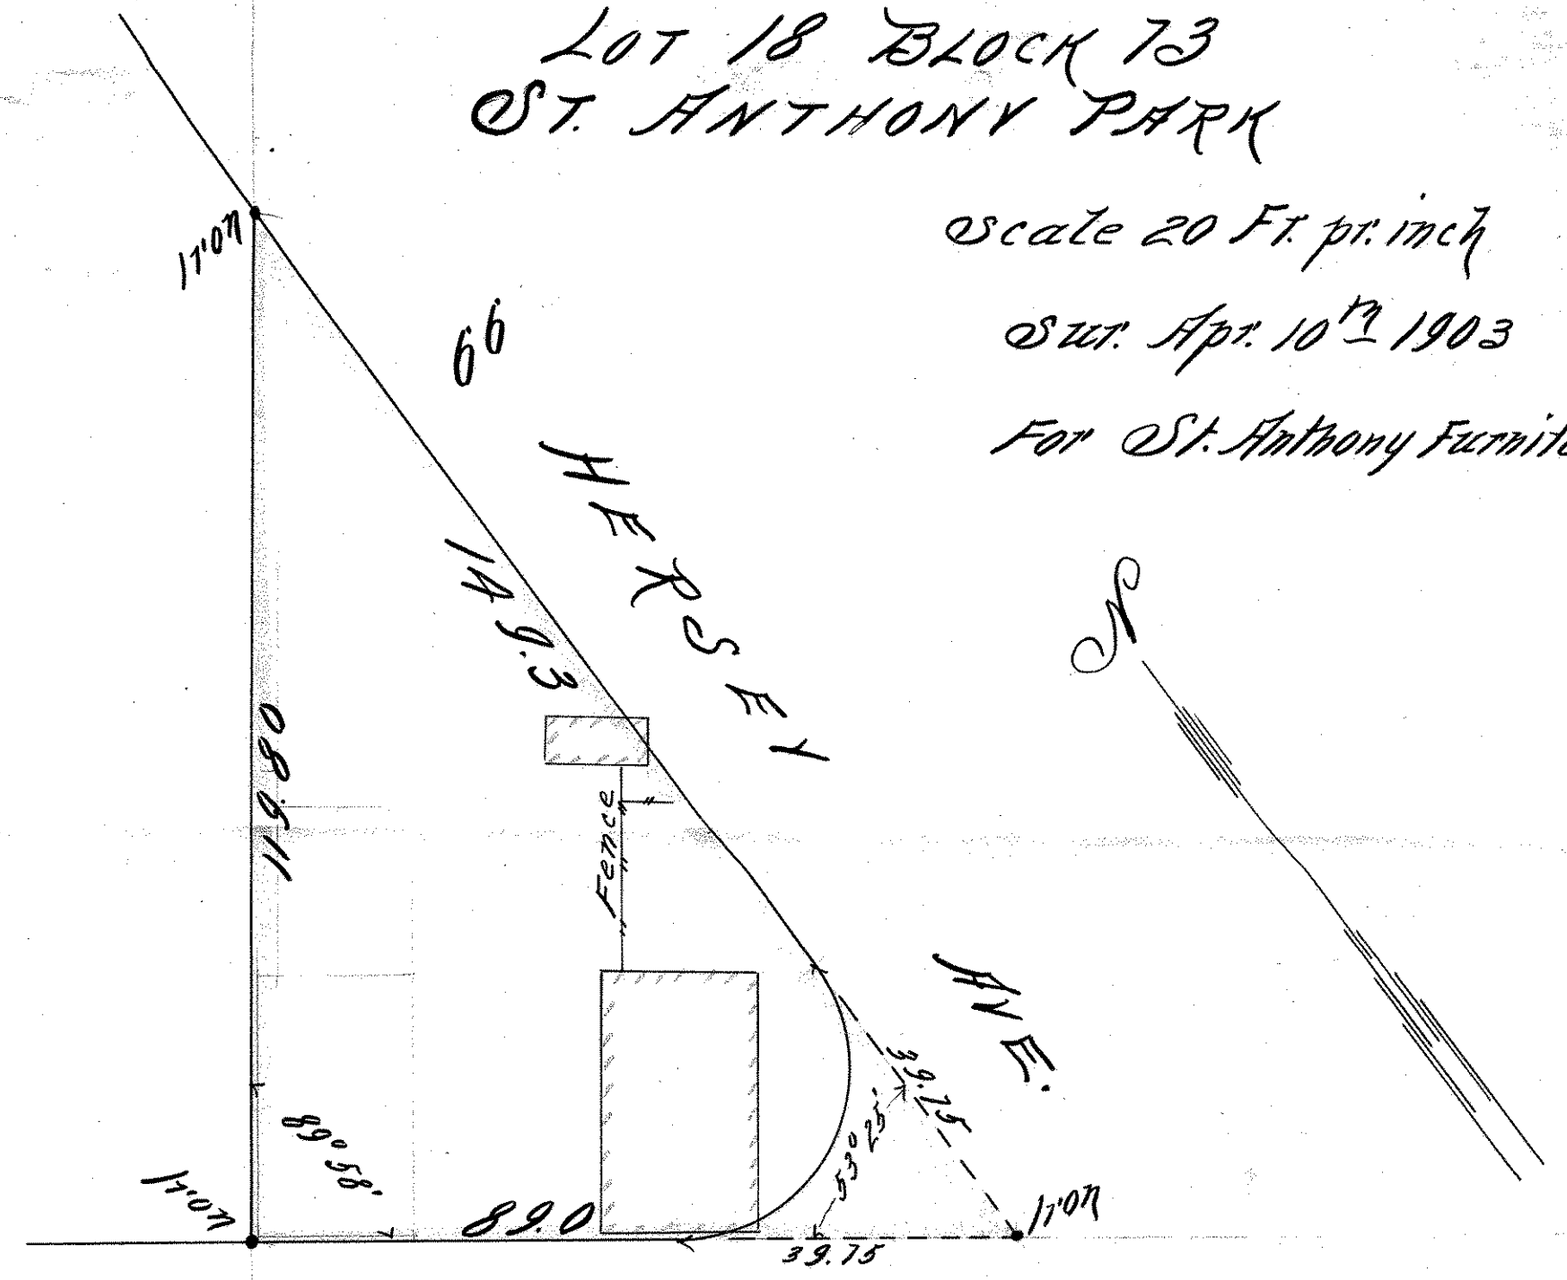

HAMPDEN 60 AVE.